USE TYPEWRITER OR BALL POINT PEN-PRESS FIRMLY, PRINT CLEARLY.

T	R	EW	sec 1/4 1/4 1/4 No.

WATER WELL RECORD
KSA 82a-1201-1215

BBB BBC

Kansas State Dept. Of Health
(Water Well Contractors)
Forbes-Bldg. 740
Topeka, Kansas 66620

1 Location of well:	County	Township name	Fraction	Section number	Town number	Range number
	Rawlins	Arbor	NW NW 1/4 of NW	32	4	33

Distance and direction from nearest town or city: 9 mi South of Atwood, Ks.
Street address of well location if in city:

3 Owner of well: C. G. Nash
Address: Atwood, Kan 67730

Locate with "X" in section below:

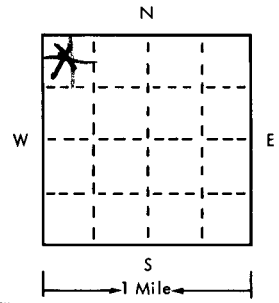

Sketch map:

4 Well depth: 256 ft. Date of completion 6-18-75
Well diameter 30 in.

5 ☐ Cable tool ☐ Rotary ☐ Driven ☐ Dug ☐ Hollow rod ☐ Jetted ☐ Bored ☒ Reverse rotary

6 Use: ☐ Domestic ☐ Public supply ☐ Industry ☒ Irrigation ☐ Air conditioning ☐ Commercial ☐ Test well ☐

7 Casing: Material Steel Threaded ☐ Welded ☒ Diam. 16 in. to 256 ft. depth ___ in. to ___ ft. depth
Height: above/below Surface 12 in. Weight 32 lbs./ft. Drive shoe? ☐ Yes ☒ No

2

Type and color of material	From	To
11' loose gravel 4' porous rock & clay	150	165
15' loose porous rock	165	180
15' very loose porous rock & fine sand	180	195
15' loose & clean fine sand	195	210
15 loose & clean fine sand	210	225
5' loose & clean fine sand 10' loose porous	225	240
1' porous rock 2' very hard rock 7' rock & little clay	240	255
cemented gravel 4' loose gravel 1' clay	[redacted]	
shale	255	256
(use a second sheet if needed)		

8 Screen:
Manufacturer W. G. Brown Enterprises
Type Free flow Dia. 16"
Slot/gauze 3/4 Length 40'
Set between 214 ft. and 256 ft.
Fittings:
Gravel pack ☒ Yes ☐ No Size range of material 3/4"

9 Static water level: 190 ft. below land surface Date 6-18-75

10 Pumping level below land surfaces: 250 ft. after 1 hrs. pumping 475 g.p.m.
___ ft. after ___ hrs. pumping ___ g.p.m.
Estimated maximum yield 475 g.p.m.

11 Water sample submitted: ☐ Yes ☒ No Date ___

12 Well head completion: 12" ☐ Pitless adapter ☒ Inches above grade

13 Well grouted? ☒ Yes ☐ No Puddled Clay ☐ Neat cement ☐ Bentonite ☐
Depth: From 0 ft. to 10 ft.

14 Nearest source of possible contamination:
ft. ___ Direction ___ Type ___
Well disinfected upon completion? ☐ Yes ☒ No

15 Pump: ☐ Not installed
Manufacturer's name Western Land Roller
Model number 10MC HP [redacted] Volts 480
Length of drop pipe 250 ft. capacity 500 g.m.p.
Type:
☐ Submersible ☒ Turbine
☐ Jet ☐ Reciprocating
☐ Certrifugal ☐ Other

16 Remarks: elevation 3154 (TOPO) 3163

Topography:
☐ Hill
☐ Slope
☒ Upland
☐ Valley

irrigation Well

17 Water well contractor's certification:
This well was drilled under my jurisdiction and this report is true to the best of my knowledge and belief.
Jack Poore Drilling 197
Business name License No.
Address McDonald Ks
Signed Jack Poore Date 6-18-75
Authorized representative

Forward the white, blue and pink copies to the Kansas State Dept. Of Health.

Form WWC-5