

USE TYPEWRITER OR BALL POINT PEN-PRESS FIRMLY, PRINT CLEARLY.


WATER WELL RECORD
KSA 82a-1201-1215

BDD

Kansas Department of Health and Environment-Division of Environment (Water well Contractors) Topeka, Kansas 66620

1. Location of well: County RAWLINS Section SE 1/4 SE 1/4 NW 1/4 Section number 1 Township number T 4 S R 34 W Range number 34

2. Distance and direction from nearest town or city: 5 South 2 west of Atwood 3. Owner of well: JOHN MC CAIN
Street address of well location if in city: 605 N 7 R.R. or street:
City, state, zip code: ATWOOD, KAN, 67730

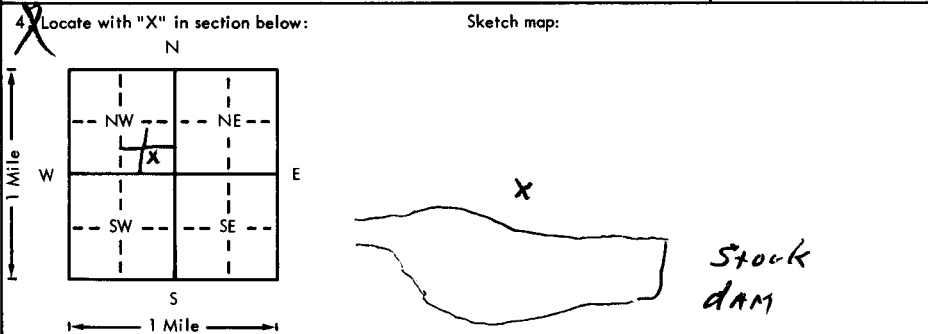

6. Bore hole dia. 8 in. Completion date Well Drilled 10/4/77
Well depth 115 ft.
7. Cable tool Rotary Driven Dug
 Hollow rod Jetted Bored Reverse rotary
8. Use: Domestic Public supply Industry
 Irrigation Air conditioning Stock
 Lawn Oil field water Other
9. Casing: Material Height: Above or below
Threaded Welded Surface 24 in.
RMP PVC Weight lbs./ft.
Dia. 5 in. to 13 ft. depth Wall Thickness: inches or
Dia. 5 in. to 115 ft. depth gage No. 01214

5. Type and color of material	From	To
Top soil	0	1
clay silty Lt Brown	1	18
SAND fine BROWN	18	45
CLAY + SAND BROWN	45	70
Rock white + brown	70	80
Rock + gravel fine Dark Brown	80	100
gravel fine to coarse BROWN	100	113
Shale slick GRAY + yellow	113	115
(Use a second sheet if needed)		

10. Screen: Manufacturer's name SDR 26
MPI PVC 1120 NSF PM
Type PVC Dia. 5"
Slot/gauge 3/16 Length 10'
Set between 105 ft. and 115 ft.
ft. and 115 ft.
Gravel pack? Size range of material 1/4 to 1/2"
11. Static water level: 80 ft. below land surface Date 10/4/77 mo./day/yr.
12. Pumping level below land surfaces:
80 ft. after 0 hrs. pumping 0 g.p.m.
0 ft. after 0 hrs. pumping 0 g.p.m.
Estimated maximum yield 0 g.p.m.
13. Water sample submitted: 0 mo./day/yr.
 Yes No Date 10/4/77
14. Well head completion:
 Pitless adapter 0 Inches above grade
15. Well grouted?
With: Neat cement Bentonite Concrete
Depth: From 1 ft. to 12 ft.
16. Nearest source of possible contamination:
ft. 300' Direction South Type Stock Dam
Well disinfected upon completion? Yes No
17. Pump: Not installed
Manufacturer's name _____
Model number _____ HP _____ Volts _____
Length of drop pipe _____ ft. capacity _____ g.p.m.
Type:
 Submersible Turbine
 Jet Reciprocating
 Centrifugal Other

18. Elevation: _____
Topography: Hill _____
 Slope _____
 Upland _____
 Valley _____
19. Remarks: (Called JOHN and He has installed grout)
John with installed grout + slab.
I left gravel pack down 12'.

20. Water well contractor's certification:
This well was drilled under my jurisdiction and this report is true to the best of my knowledge and belief.
H A Drilling 331
Business name License No.
Address Atwood KAN.
Signed Harry A. Beasley Date 11/2/77
Authorized representative

T-4 34 W-1 SE SE NW 1/4