USE TYPEWRITER OR BALL POINT PEN-PRESS FIRMLY, PRINT CLEARLY.

CHARLON NW

ADA

WATER WELL RECORD
KSA 82a-1201-1215

Kansas Department of Health and Environment-Division of Environment
(Water well Contractors)
Topeka, Kansas 66620

1. Location of well:	County	Fraction	Section number	Township number	Range number
	Rawlins	NE 1/4 SE 1/4 NE 1/4	18	T 4 S	R 34 E/W

2. Distance and direction from nearest town or city: 7 3/4 South; 6½ West Atwood, KS
Street address of well location if in city:

3. Owner of well: Don Dixon
R.R. or street: R R #1
City, state, zip code: Atwood, KS 67730

4. Locate with "X" in section below:

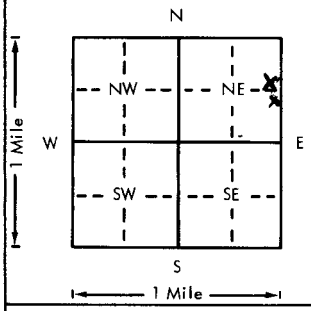

Sketch map:

6. Bore hole dia. 30 in. Completion date
Well depth 58 ft. 11-22-78

7. __ Cable tool __ Rotary __ Driven __ Dug
__ Hollow rod __ Jetted __ Bored X Reverse rotary

8. Use: __ Domestic __ Public supply __ Industry
X Irrigation __ Air conditioning __ Stock
__ Lawn __ Oil field water __ Other

9. Casing: Material Steel Height: Above or below
Threaded ___ Welded X Surface 12 in.
RMP ___ PVC ___ Weight 31.75 lbs./ft.
Dia. 16 in. to 58 ft. depth Wall Thickness: inches or
Dia. ___ in. to ___ ft. depth gage No. .188

10. Screen: Manufacturer's name Cook
Type Wire Wrapped Dia. 16
Slot/gauze 100 Length 10
Set between 48 ft. and 58 ft.
ft. and ft.
Gravel pack? X Size range of material 30%#1-70%¼x5/

5. Type and color of material	From	To
Clay and Top Soil	0	37
Fine Sand	37	43
Medium Gravel and Gravel	43	55
Blue Shale	55	60
BROCK 55'		

(Use a second sheet if needed)

11. Static water level: mo./day/yr.
27 ft. below land surface Date 11-27-78

12. Pumping level below land surfaces:
54 ft. after 2 hrs. pumping 889 g.p.m.
ft. after hrs. pumping g.p.m.
Estimated maximum yield 889 g.p.m.

13. Water sample submitted: mo./day/yr.
__ Yes X No Date

14. Well head completion:
__ Pitless adapter 12 Inches above grade

15. Well grouted? Yes
With: __ Neat cement __ Bentonite X Concrete
Depth: From 0 ft. to 10 ft.

16. Nearest source of possible contamination:
ft. 3100 Direction WNW Type Farmstead
Well disinfected upon completion? __ Yes X No

17. Pump: __ Not installed
Manufacturer's name Floway
Model number 10 DOH HP 50 Volts
Length of drop pipe 57 ft. capacity 500 g.p.m.
Type:
__ Submersible X Turbine
__ Jet __ Reciprocating
__ Centrifugal __ Other

T 4 S R 34 E/W Sec 18 1/4 SE 1/4 NE 1/4 NE 1/4

18. Elevation:
Topography:
__ Hill
__ Slope
__ Upland
X Valley

19. Remarks: 3015 (TOPO)

20. Water well contractor's certification:
This well was drilled under my jurisdiction and this report is true to the best of my knowledge and belief.
Business name Western Well & Pump, Inc. License No. 245
Address Box 852 Colby, KS 67701
Signed D D Calhoun Date 12-18-78
Authorized representative

Forward the white, blue and pink copies to the Department of Health and Environment

Form WWC-5