


USE TYPEWRITER OR BALL POINT PEN—PRESS FIRMLY, PRINT CLEARLY.

WATER WELL RECORD
KSA 82a-1201-1215

Kansas Department of Health and Environment—Division of Environment
(Water well Contractors)
Topeka, Kansas 66620

1. Location of well: County RAWLINS Fraction NE 1/4 NE 1/4 SE 1/4 Section number 24 Township number T 4 S R 34 Range number 01W

2. Distance and direction from nearest town or city: 7 South 1 west + 2 South at Atwood
3. Owner of well: Hyle Bowles
Street address of well location if in city: RT 1
R.R. or street: Atwood, KAN 67230
City, state, zip code: Atwood, KAN 67230

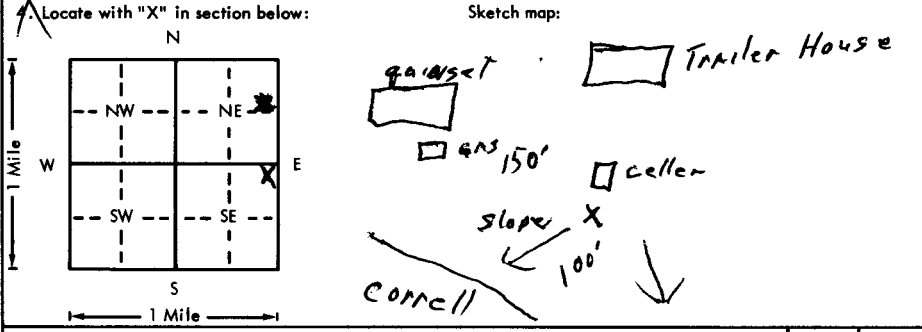

6. Bore hole dia. 8 in. Completion date Dated 11/9/76
Well depth 168 ft.
7. Cable tool Rotary Driven Aug
 Hollow rod Jetted Bored Reverse rotary
8. Use: Domestic Public supply Industry
 Irrigation Air conditioning Stock
 Lawn Oil field water Other
9. Casing: Material _____ Height: Above or below
Threaded _____ Welded _____ Surface 24 in.
RMP _____ PVC Weight _____ lbs./ft.
Dia. 5 in. to 168 ft. depth; Wall Thickness: inches or
Dia. _____ in. to _____ ft. depth; gage No. 92

5. Type and color of material	From	To
Top Soil	0	3
CLAY silty <u>Brown</u>	3	100
Rock <u>s</u> <u>white</u>	100	105
CLAY + <u>FINE</u> SAND <u>Brown</u>	105	132
Rock <u>Redish Brown</u>	132	135
CLAY + FINE SAND <u>Brown</u>	135	140
FINE SAND <u>Brown</u>	140	150
Med SAND	150	160
Med TO coarse SAND	160	168
Shale slick <u>Brownish yellow</u>	167	168

10. Screen: Manufacturer's name Jessy Lowell Superior Well CASING
Type PVC Dia. 5
Slot/gauze 1/8 Length 20'
Set between 148 ft. and 168 ft.
Gravel pack? Size range of material 1/4 to 1/2
11. Static water level: _____ mo./day/yr.
140 ft. below land surface Date 11/19/76
12. Pumping level below land surfaces:
_____ ft. after _____ hrs. pumping _____ g.p.m.
_____ ft. after _____ hrs. pumping _____ g.p.m.
Estimated maximum yield _____ g.p.m.
13. Water sample submitted: _____ mo./day/yr.
Yes No Date _____
14. Well head completion:
 Pitless adapter _____ Inches above grade
15. Well grouted? yes
With: Neat cement Bentonite Concrete
Depth: From 4 ft. to 14 ft.
16. Nearest source of possible contamination:
ft. 100 Direction Southwest Type Correll
Well disinfected upon completion? Yes No
17. Pump: _____ Not installed
Manufacturer's name _____
Model number _____ HP _____ Volts _____
Length of drop pipe _____ ft. capacity _____ g.p.m.
Type:
 Submersible Turbine
 Jet Reciprocating
 Centrifugal Other

18. Elevation: _____
Topography: _____ Hill _____ Slope _____ Upland _____ Valley _____
19. Remarks: Goute, pitless adapter + pump installed by Rawlins County Well service

20. Water well contractor's certification:
This well was drilled under my jurisdiction and this report is true to the best of my knowledge and belief.
H.A. DRILLING 331
Business name _____ License No. _____
Address Route 2 Atwood
Signed Harry Q. Beasley Date 12/1/76
Authorized representative

T 4 S R 34 W E 24 NE 1/4 SE 1/4