

USE TYPEWRITER OR BALL POINT PEN-PRESS FIRMLY, PRINT CLEARLY.

T R EW sec 1/4 1/4 1/4 No.

WATER WELL RECORD
KSA 82g-1201-1215


14 FB

Kansas State Dept. Of Health
(Water Well Contractors)
Forbes-Bldg. 740
Topeka, Kansas 66620

1 Location of well: County Rawlins Township name Mirage NE1 Fraction NW 1/4 of NE 1/4 Section number 9 Town number 4 Range number 35

Distance and direction from nearest town or city: 1/2 miles So of Breadsley
Street address of well location if in city:

3 Owner of well: Syndon Montgomery
Address: McDonald Rr 67745

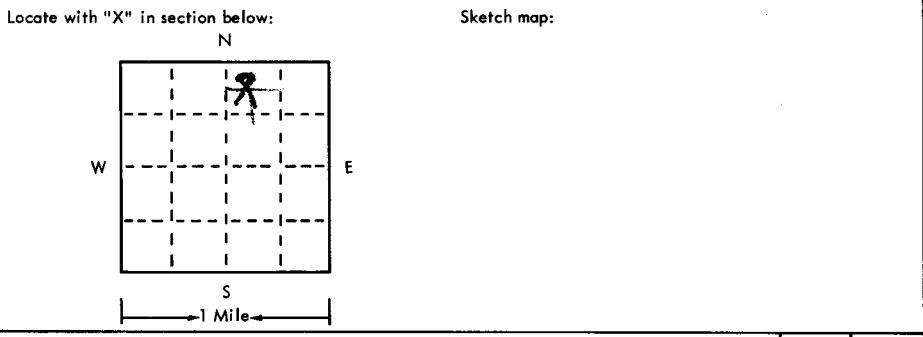

4 Well depth: 240 ft. Date of completion 6-15-75
Well diameter 8 in.

5 Cable tool Rotary Driven Dug
 Hollow rod Jetted Bored Reverse rotary

6 Use: Domestic Public supply Industry
 Irrigation Air conditioning Commercial
 Test well

7 Casing: Material Plastic Height: above below
Threaded Welded Surface 12 in.
Diam. 8 in. Weight _____ lbs./ft.
8 in. to 240 ft. depth Drive shoe? Yes No
_____ in. to _____ ft. depth!

2	Type and color of material	From	To
	<u>top soil & clay</u>	<u>0</u>	<u>190</u>
	<u>10' loose porous rock</u>	<u>190</u>	<u>200</u>
	<u>10' loose porous rock (loose)</u>	<u>200</u>	<u>210</u>
	<u>4' porous rock 6' clay & carbon clay</u>	<u>210</u>	<u>220</u>
	<u>4' clay 3' gravel & sand</u>	<u>220</u>	<u>230</u>
	<u>10' gravel little rock</u>	<u>230</u>	<u>240</u>
	<u>FRONT ?</u>		

8 Screen: Manufacturer Jess and Lowell
Type 512 Dia. 8"
60 gauze Length 20'
Set between 220 ft. and 240 ft.
Fittings: 3/8" to 1/2"
Gravel pack Yes No Size range of material _____

9 Static water level: 200 ft. below land surface Date 6-17-75

10 Pumping level below land surfaces:
230 ft. after 24 hrs. pumping _____ g.p.m.
_____ ft. after _____ hrs. pumping _____ g.p.m.
Estimated maximum yield 100 g.p.m.

11 Water sample submitted:
 Yes No Date _____

12 Well head completion: 10'
 Pitless adapter _____ inches above grade

13 Well grouted? Yes No Grouted
 Neat cement Bentonite clay
Depth: From 0 ft. to 10 ft.

14 Nearest source of possible contamination:
ft. _____ Direction _____ Type _____
Well disinfected upon completion? Yes No

15 Pump: Not installed
Manufacturer's name Red Jacket Submers
Model number 156R1 HP 7 1/2 Volts 220
Length of drop pipe 230 ft. capacity 100 g.m.p.
Type:
 Submersible Turbine
 Jet Reciprocating
 Centrifugal Other

16 Remarks: elevation 3246 (TOP)
Topography:
 Hill
 Slope
 Upland
 Valley

17 Water well contractor's certification:
This well was drilled under my jurisdiction and this report is true to the best of my knowledge and belief.
Jack Poore Shilling 197
Business name _____ License No. _____
Address McDonald Rr
Signed Jack Poore Date 7-15-75
Authorized representative