


1 LOCATION OF WATER WELL: County: <u>Rawlins</u>	Fraction <u>SW 1/4 SW 1/4 SW 1/4</u>	Section Number <u>7</u>	Township Number <u>T 4 S</u>	Range Number <u>R 36 E/W</u>
---	---	----------------------------	---------------------------------	---------------------------------

Distance and direction from nearest town or city street address of well if located within city?
2 West 4 south of McDonald

2 WATER WELL OWNER: RR#, St. Address, Box # : City, State, ZIP Code	<u>Lauree Goltl Rt 2 McDonald</u>	Central Operating 575 Union Blvd. Suite 203, Lakewood, CO.	Board of Agriculture, Division of Water Resources Application Number:
---	---------------------------------------	--	--

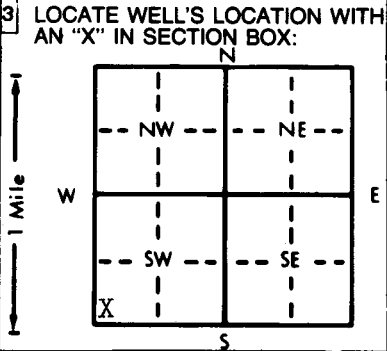

4 DEPTH OF COMPLETED WELL... <u>270</u> ft. ELEVATION:
Depth(s) Groundwater Encountered 1. ft. 2. ft. 3. ft.
WELL'S STATIC WATER LEVEL... <u>186</u> ft. below land surface measured on mo/day/yr
Pump test data: Well water was ft. after hours pumping gpm
Est. Yield gpm: Well water was ft. after hours pumping gpm
Bore Hole Diameter... <u>9</u> in. to <u>270</u> ft., and in. to ft.
WELL WATER TO BE USED AS:
5 Public water supply 8 Air conditioning 11 Injection well
1 Domestic 3 Feedlot 6 Oil field water supply 9 Dewatering 12 Other (Specify below)
2 Irrigation 4 Industrial 7 Lawn and garden only 10 Observation well
Was a chemical/bacteriological sample submitted to Department? Yes.....No.....; If yes, mo/day/yr sample was submitted
Water Well Disinfected? Yes No

5 TYPE OF BLANK CASING USED:	5 Wrought iron	8 Concrete tile	CASING JOINTS: Glued	Clamped
1 Steel	3 RMP (SR)	6 Asbestos-Cement	9 Other (specify below)	Welded
2 PVC	4 ABS	7 Fiberglass		Threaded
Blank casing diameter... <u>5</u> in. to <u>250</u> ft., Dia... in. to ... ft., Dia... in. to ... ft.				
Casing height above land surface... <u>3</u> Below... in., weight... lbs./ft. Wall thickness or gauge No.				
TYPE OF SCREEN OR PERFORATION MATERIAL:	7 PVC	10 Asbestos-cement		
1 Steel	3 Stainless steel	5 Fiberglass	8 RMP (SR)	11 Other (specify)
2 Brass	4 Galvanized steel	6 Concrete tile	9 ABS	12 None used (open hole)
SCREEN OR PERFORATION OPENINGS ARE:	5 Gauzed wrapped	8 Saw cut	11 None (open hole)	
1 Continuous slot	3 Mill slot	6 Wire wrapped	9 Drilled holes	
2 Louvered shutter	4 Key punched	7 Torch cut	10 Other (specify)	
SCREEN-PERFORATED INTERVALS: From... <u>250</u> ft. to ... <u>270</u> ft., From ... ft. to ... ft.				
GRAVEL PACK INTERVALS: From ... ft. to ... ft., From ... ft. to ... ft.				

6 GROUT MATERIAL:	1 Neat cement	2 Cement grout	3 Bentonite	4 Other
Grout intervals: From... ft. to ... ft., From ... ft. to ... ft., From ... ft. to ... ft.				
What is the nearest source of possible contamination:	1 Septic tank	4 Lateral lines	7 Pit privy	10 Livestock pens
	2 Sewer lines	5 Cess pool	8 Sewage lagoon	11 Fuel storage
	3 Watertight sewer lines	6 Seepage pit	9 Feedyard	12 Fertilizer storage
				13 Insecticide storage
Direction from well?				14 Abandoned water well
				15 Oil well/Gas well
				16 Other (specify below)
				How many feet?

FROM	TO	LITHOLOGIC LOG	FROM	TO	LITHOLOGIC LOG
<u>270</u>	<u>186</u>	Gravel Pack			
<u>186</u>	<u>6</u>	Clay			
<u>6</u>	<u>3</u>	Cement Grout			

7 CONTRACTOR'S OR LANDOWNER'S CERTIFICATION: This water well was (1) constructed, (2) reconstructed, or (3) plugged under my jurisdiction and was completed on (mo/day/year) <u>4/2/86</u> and this record is true to the best of my knowledge and belief. Kansas Water Well Contractor's License No. <u>394</u> This Water Well Record was completed on (mo/day/yr) <u>8-26-86</u> under the business name of <u>Woofter Pump & Well</u> by (signature) <u>Walt Wolf</u>

INSTRUCTIONS: Use typewriter or ball point pen. PLEASE PRESS FIRMLY and PRINT clearly. Please fill in blanks, underline or circle the correct answers. Send top three copies to Kansas Department of Health and Environment, Office of Oil Field and Environmental Geology, Regulation and Permitting Section, Topeka, Kansas 66620-7500, Telephone: 913-862-9360. Send one to WATER WELL OWNER and retain one for your records.