


USE TYPEWRITER OR BALL POINT PEN-PRESS FIRMLY, PRINT CLEARLY.

WATER WELL RECORD
KSA 82a-1201-1215

Kansas Department of Health and Environment-Division of Environment (Water well Contractors) Topeka, Kansas 66620

1. Location of well: County Rawlins Section NW NE Section number 15 Township number T 4 S Range number R 36

2. Distance and direction from nearest town or city: 5 and 1/2 miles So & 1 East of McDonald Ks
Street address of well location if in city: McDonald Ks
3. Owner of well: Kenneth House
R.R. or street: McDonald Ks 67745
City, state, zip code: McDonald Ks 67745

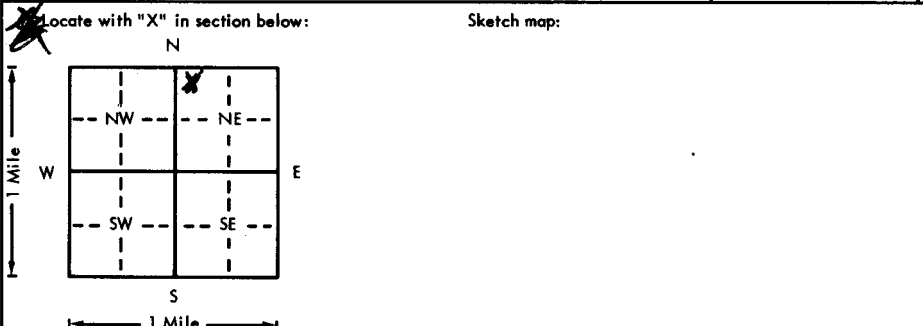

6. Bore hole dia. 8 3/8 in. Completion date 10-10-76
Well depth 190 ft.
7. Cable tool Rotary Driven Dug
 Hollow rod Jetted Bored Reverse rotary
8. Use: Domestic Public supply Industry
 Irrigation Air conditioning Stock
 Lawn Oil field water Other

5. Type and color of material	From	To
<u>top soil and clay</u>	<u>0</u>	<u>30</u>
<u>porous rock - strips of rock & clay</u>	<u>30</u>	<u>42</u>
<u>rock</u>	<u>42</u>	<u>62</u>
<u>Med sand & gravel light strips of clay</u>	<u>62</u>	<u>100</u>
<u>rock</u>	<u>100</u>	<u>105</u>
<u>fine sand</u>	<u>105</u>	<u>120</u>
<u>porous rock strips of clay</u>	<u>120</u>	<u>135</u>
<u>porous rock</u>	<u>135</u>	<u>160</u>
<u>clay</u>	<u>160</u>	<u>170</u>
<u>course gravel</u>	<u>170</u>	<u>185</u>
<u>shale</u>	<u>185</u>	<u>190</u>

9. Casing: Material _____ Height: Above or below
Threaded _____ Welded _____ Surface 12 in.
RMP _____ PVC Weight _____ lbs./ft.
Dia. 5 in. to 190 ft. depth Wall Thickness: inches or
Dia. _____ in. to _____ ft. depth gage No. 0.250
10. Screen: Manufacturer's name Pumpro
Type Plastic Dia. 5"
Slot/gduze 1/8" Length 2'20"
Set between 170 ft. and 190 ft.
Gravel pack? Size range of material 1/8 to 1/4"
11. Static water level: _____ mo./day/yr.
9.3 ft. below land surface Date 10/11/76
12. Pumping level below land surfaces: 13 Barbings
9.3 ft. after 3 hrs. pumping 500 g.p.m.
_____ ft. after _____ hrs. pumping _____ g.p.m.
Estimated maximum yield 50 g.p.m.
13. Water sample submitted: _____ mo./day/yr.
Yes No _____ Date _____
14. Well head completion: _____ Pitless adapter _____ Inches above grade
15. Well grouted? Buddled clay
With: _____ Neat cement _____ Bentonite _____ Concrete
Depth: From 0 ft. to 10 ft.
16. Nearest source of possible contamination: _____ ft. _____ Direction _____
Well disinfected upon completion? _____ Yes _____ No
17. Pump: Not installed
Manufacturer's name _____ HP _____ Volts _____
Length of drop pipe _____ ft. capacity _____ g.p.m.
Type: _____ Submersible _____ Turbine
_____ Jet _____ Reciprocating
_____ Centrifugal _____ Other

18. Elevation: _____
19. Remarks: Farmer to install windmill
Topography: _____ Hill
_____ Slope
 Upland
_____ Valley

20. Water well contractor's certification:
This well was drilled under my jurisdiction and this report is true to the best of my knowledge and belief.
Jack Pool 197
Business name _____ License No. _____
Address: McDonald Ks 67745
Signed Jack Pool Date 10/15/76
Authorized representative

76
4-36-76
15
1/4 1/4 1/4
Sec