


1 LOCATION OF WATER WELL: Fraction SE 1/4 SE 1/4 SE 1/4 Section Number 36 Township Number T 4 S Range Number R 36 E/W

County: Rawlins
 Distance and direction from nearest town or city street address of well if located within city?
4 miles East, 9 miles South of McDonald, Ks.

2 WATER WELL OWNER: Walter Biggs
 RR#, St. Address, Box #: Rt. 2 Board of Agriculture, Division of Water Resources
 City, State, ZIP Code: McDonald, Ks. 67745 Application Number:

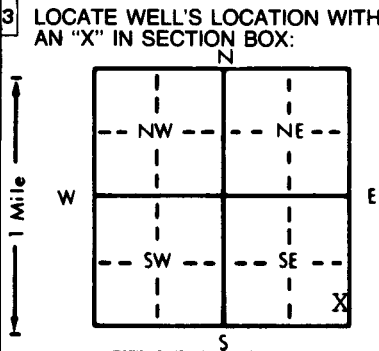

4 DEPTH OF COMPLETED WELL: 168 ft. ELEVATION:
 Depth(s) Groundwater Encountered 1. ft. 2. ft. 3. ft.
 WELL'S STATIC WATER LEVEL: 72 ft. below land surface measured on mo/day/yr
 Pump test data: Well water was ft. after hours pumping gpm
 Est. Yield gpm: Well water was ft. after hours pumping gpm
 Bore Hole Diameter: 8 in. to 168 ft., and in. to ft.
 WELL WATER TO BE USED AS: 5 Public water supply 8 Air conditioning 11 Injection well
 1 Domestic 3 Feedlot 6 Oil field water supply 9 Dewatering 12 Other (Specify below)
 2 Irrigation 4 Industrial 7 Lawn and garden only 10 Monitoring well
 Was a chemical/bacteriological sample submitted to Department? Yes.....No X.....; If yes, mo/day/yr sample was submitted Water Well Disinfected? Yes No X

5 TYPE OF BLANK CASING USED:
 1 Steel 3 RMP (SR) 5 Wrought iron 8 Concrete tile CASING JOINTS: Glued X Clamped
 2 PVC 4 ABS 6 Asbestos-Cement 9 Other (specify below) Welded
 7 Fiberglass Threaded
 Blank casing diameter: 4.5 in. to 128 ft., Dia in. to ft., Dia in. to ft.
 Casing height above land surface: 18 in., weight 2.38 lbs./ft. Wall thickness or gauge No. .248
 TYPE OF SCREEN OR PERFORATION MATERIAL:
 1 Steel 3 Stainless steel 5 Fiberglass 7 PVC 10 Asbestos-cement
 2 Brass 4 Galvanized steel 6 Concrete tile 8 RMP (SR) 11 Other (specify)
 9 ABS 12 None used (open hole)
 SCREEN OR PERFORATION OPENINGS ARE:
 1 Continuous slot 3 Mill slot 5 Gauzed wrapped 8 Saw cut 11 None (open hole)
 2 Louvered shutter 4 Key punched 6 Wire wrapped 9 Drilled holes
 7 Torch cut 10 Other (specify)
 SCREEN-PERFORATED INTERVALS: From 128 ft. to 168 ft., From ft. to ft.
 GRAVEL PACK INTERVALS: From 20 ft. to 168 ft., From ft. to ft.

6 GROUT MATERIAL: 1 Neat cement 2 Cement grout 3 Bentonite 4 Other
 Grout intervals: From 0 ft. to 20 ft., From ft. to ft.
 What is the nearest source of possible contamination:
 1 Septic tank 4 Lateral lines 7 Pit privy 10 Livestock pens 14 Abandoned water well
 2 Sewer lines 5 Cess pool 8 Sewage lagoon 11 Fuel storage 15 Oil well/Gas well
 3 Watertight sewer lines 6 Seepage pit 9 Feedyard 12 Fertilizer storage 16 Other (specify below)
 13 Insecticide storage
 Direction from well? SE How many feet? 65

FROM	TO	LITHOLOGIC LOG	FROM	TO	PLUGGING INTERVALS
0	2	Surface	123	128	Fine Sand/Clay Strks.
2	9	Silt	128	131	Sandy Clay
9	19	Clay & Sandstone Strks.	131	134	Fine Sand
19	24	Med. Sand	134	138	Clay, Caliche & Fine Sand Strks
24	49	Clay & Sand Strks.	138	141	Fine Sand
49	50	Caliche	141	144	Grey Sandstone
50	52	Med. Sand	144	148	Clay
52	56	Cemented Sand	148	149	Sandstone
56	63	Caliche	149	154	Clay & Caliche
63	72	Cemented Sand	154	157	Sand
72	78	Caliche Clay & Fine Sandstone	157	162	Clay/Green
78	84	Tight Fine Sand	Lyrs	162	168
84	88	Caliche & Clay			
88	112	Tight Fine Sand			
112	123	Clay & Sand Strks.			

7 CONTRACTOR'S OR LANDOWNER'S CERTIFICATION: This water well was (1) constructed, (2) reconstructed, or (3) plugged under my jurisdiction and was completed on (mo/day/year) 6-28-93 and this record is true to the best of my knowledge and belief. Kansas Water Well Contractor's License No. 554 This Water Well Record was completed on (mo/day/yr) 6-29-93 under the business name of Woofter Pump & Well, Inc. by (signature) Jay G. Woofter

INSTRUCTIONS: Use typewriter or ball point pen. PLEASE PRESS FIRMLY and PRINT clearly. Please fill in blanks, underline or circle the correct answers. Send top three copies to Kansas Department of Health and Environment, Bureau of Water, Topeka, Kansas 66620-0001. Telephone: 913-296-5545. Send one to WATER WELL OWNER and retain one for your records.