

USE TYPEWRITER OR BALL POINT PEN—PRESS FIRMLY, PRINT CLEARLY.


ADD WATER WELL RECORD KSA 82a-1201-1215

Kansas Department of Health and Environment—Division of Environment (Water well Contractors) Topeka, Kansas 66620

NW SE NE

1. Location of well: County Cheyenne Fraction SE 1/4 NE 1/4 1/4 Section number 2 Township number T 4 S R 37 E Range number

2. Distance and direction from nearest town or city: 4 1/2 mi 3/4 W of McDonald Ks Street address of well location if in city:
 3. Owner of well: ETTA Harper R.R. or street: R.R. 1 City, state, zip code: Bind City, KS 67131

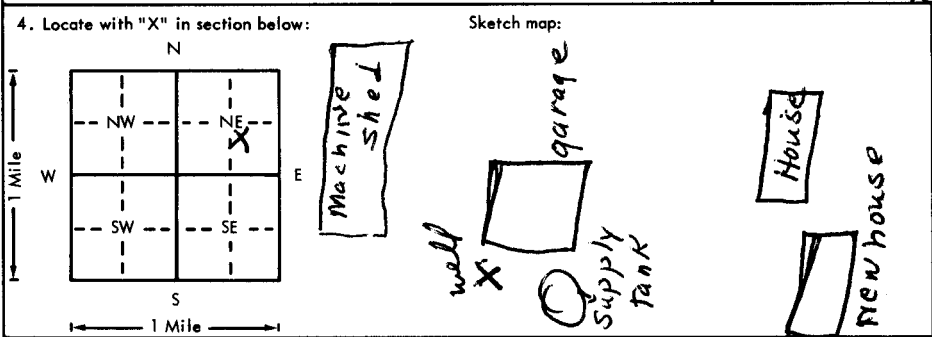

6. Bore hole dia. 5 1/2 in. Completion date 10/15/76
 Well depth 300 ft.

7. Cable tool Rotary Driven Dug
 Hollow rod Jetted Bored Reverse rotary

8. Use: Domestic Public supply Industry
 Irrigation Air conditioning Stock
 Lawn Oil field water Other

9. Casing: Material Plastic Height: Above or below
 Threaded Welded Surface 12 in.
 RMP PVC Weight lbs./ft.
 Dia. 5 in. to 220 ft. depth Wall Thickness: inches or
 Dia. in. to ft. depth gage No. 0.250

5. Type and color of material	From	To
Topsoil	0	1
clay, silty brown	1	73
porous rock	73	95
rock	95	103
Sand, very fine w/ strips of clay	103	142
gravel	142	180
clay-w/ strips of fine sand	180	192
porous rock	192	226
fine sand	226	242
medium sand	242	270
course gravel	270	300

10. Screen: Manufacturer's name Pump Co MPI
 Type P.V.C Dia. 5"
 Slot/gauze 1/8" Length 2' 80'
 Set between 220 ft. and 300 ft.
 Gravel pack? Size range of material 1/4"-1/2"

11. Static water level: 187 ft. below land surface Date 10/15/76 mp./day/yr.

12. Pumping level below land surfaces:
198 ft. after 1 hrs. pumping 25 g.p.m.
198 ft. after 14 hrs. pumping 25 g.p.m.
 Estimated maximum yield 200 g.p.m.

13. Water sample submitted: mo./day/yr.
 Yes No Date

14. Well head completion:
 Pitless adapter 10 inches above grade

15. Well grouted? Puddled clay
 With: Neat cement Bentonite Concrete
 Depth: From 6 ft. to 26 ft.

16. Nearest source of possible contamination: Cess
 ft. 600 Direction East Type pool
 Well disinfected upon completion? Yes No

17. Pump: Not installed
 Manufacturer's name Redg
 Model number HP 1.5 Volts 220
 Length of drop pipe 290 ft. capacity 40 g.p.m.
 Type: Submersible Turbine
 Jet Reciprocating
 Centrifugal Other

18. Elevation: 3790 (top)
 Topography: Hill Slope Upland Valley

19. Remarks:

20. Water well contractor's certification:
 This well was drilled under my jurisdiction and this report is true to the best of my knowledge and belief.
Jack Pore Drilling Co
 Business name McDonald Ks License No.
 Address
 Signed Jack Pore Date 10-18
 Authorized representative

4 37 E 2 NW NE 9 SE
 Sec 1/4 1/4