


1 LOCATION OF WATER WELL: County: Cheyenne Fraction: SE 1/4 NE 1/4 SE 1/4 Section Number: 14 Township Number: T 4 S Range Number: R 37 E/W

Distance and direction from nearest town or city street address of well if located within city?
6 East 3/4 So of Bird City KS.

2 WATER WELL OWNER: Charlotte Wageman
 RR#, St. Address, Box #: 203 N. 5th Board of Agriculture, Division of Water Resources
 City, State, ZIP Code: atwood ks. 67730 Application Number:

3 LOCATE WELL'S LOCATION WITH AN "X" IN SECTION BOX:

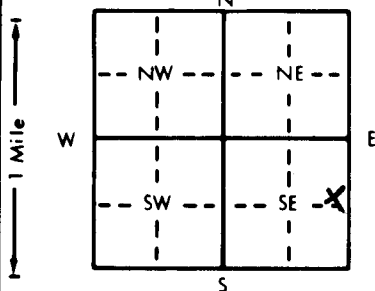

4 DEPTH OF COMPLETED WELL: 206 ft. ELEVATION: 3500

Depth(s) Groundwater Encountered 1. 95 ft. 2. ft. 3. ft.
 WELL'S STATIC WATER LEVEL 95 ft. below land surface measured on mo/day/yr 5-27-93
 Pump test data: Well water was ft. after hours pumping gpm
 Est. Yield 20 gpm; Well water was ft. after hours pumping gpm
 Bore Hole Diameter 8 in. to 208 ft., and in. to ft.
 WELL WATER TO BE USED AS:
 1 Domestic 3 Feedlot 6 Oil field water supply 9 Dewatering 12 Other (Specify below) Stock
 2 Irrigation 4 Industrial 7 Lawn and garden only 10 Monitoring well
 Was a chemical/bacteriological sample submitted to Department? Yes No X; If yes, mo/day/yr sample was submitted Water Well Disinfected? Yes X No

5 TYPE OF CASING USED:
 1 Steel 3 RMP (SR) 5 Wrought iron 8 Concrete tile CASING JOINTS: Glued X Clamped
 2 PVC 4 ABS 6 Asbestos-Cement 9 Other (specify below) Welded
 7 Fiberglass Threaded

Blank casing diameter 5 in. to 186 ft. Dia. in. to ft. Dia. in. to ft.
 Casing height above land surface 14 in. weight 2.81 lbs./ft. Wall thickness or gauge No. SOR 21

TYPE OF SCREEN OR PERFORATION MATERIAL:
 1 Steel 3 Stainless steel 5 Fiberglass 8 RMP (SR) 10 Asbestos-cement
 2 Brass 4 Galvanized steel 6 Concrete tile 9 ABS 11 Other (specify)
 SCREEN OR PERFORATION OPENINGS ARE:
 1 Continuous slot Mill slot 5 Gauzed wrapped 8 Saw cut 11 None (open hole)
 2 Louvered shutter 4 Key punched 6 Wire wrapped 9 Drilled holes
 7 Torch cut 10 Other (specify)

SCREEN-PERFORATED INTERVALS: From 186 ft. to 206 ft. From ft. to ft.
 From ft. to ft. From ft. to ft.
 GRAVEL PACK INTERVALS: From 21 ft. to 206 ft. From ft. to ft.
 From ft. to ft. From ft. to ft.

6 GROUT MATERIAL: 1 Neat cement 2 Cement grout 3 Bentonite 4 Other
 Grout intervals: From 0 ft. to 21 ft. From ft. to ft. From ft. to ft. From ft. to ft.
 What is the nearest source of possible contamination:
 1 Septic tank 4 Lateral lines 7 Pit privy 10 Livestock pens 14 Abandoned water well
 2 Sewer lines 5 Cess pool 8 Sewage lagoon 11 Fuel storage 15 Oil well/Gas well
 3 Watertight sewer lines 6 Seepage pit 9 Feedyard 12 Fertilizer storage 16 Other (specify below)
 13 Insecticide storage
 Direction from well? North How many feet? 2000 FT

FROM	TO	LITHOLOGIC LOG	FROM	TO	PLUGGING INTERVALS
0	3	Top soil			
3	49	clay			
49	81	Rock			
51	94	Sand & Gravel clay layers			
94	98	Layering of Rock - Sand			
98	123	Sand			
123	127	Rock			
127	139	Layering Sand-clay			
139	144	Rock			
144	166	Sand & Gravel			
166	169	Rock			
168	174	clay			
174	206	Sand & Gravel			
206	208	stone			

7 CONTRACTOR'S OR LANDOWNER'S CERTIFICATION: This water well was (1) constructed, (2) reconstructed, or (3) plugged under my jurisdiction and was completed on (mo/day/year) 5-27-93 and this record is true to the best of my knowledge and belief. Kansas Water Well Contractor's License No. 184 This Water Well Record was completed on (mo/day/yr) 5-28-93 under the business name of Schaecher Drilling Inc by (signature) [Signature]

INSTRUCTIONS: Use typewriter or ball point pen. PLEASE PRESS FIRMLY and PRINT clearly. Please fill in blanks, underline or circle the correct answers. Send top three copies to Kansas Department of Health and Environment, Bureau of Water, Topeka, Kansas 66620-7320. Telephone: 913-296-5545. Send one to WATER WELL OWNER and retain one for your records.