

USE TYPEWRITER OR BALL POINT PEN-PRESS FIRMLY, PRINT CLEARLY.


WATER WELL RECORD
KSA 82a-1201-1215

Kansas Department of Health and Environment-Division of Environment (Water well Contractors) Topeka, Kansas 66620

DDB

1. Location of well: County Cheyenne Fraction NE 1/4 SE 1/4 SE 1/4 Section number 19 Township number T 4 S R 37 Range number EW

2. Distance and direction from nearest town or city: Bird City;
5 South; 1 3/4 East; 1/4 North
Street address of well location if in city:
3. Owner of well: Lynn Glasco
R.R. or street:
City, state, zip code: Bird City, KS 67731

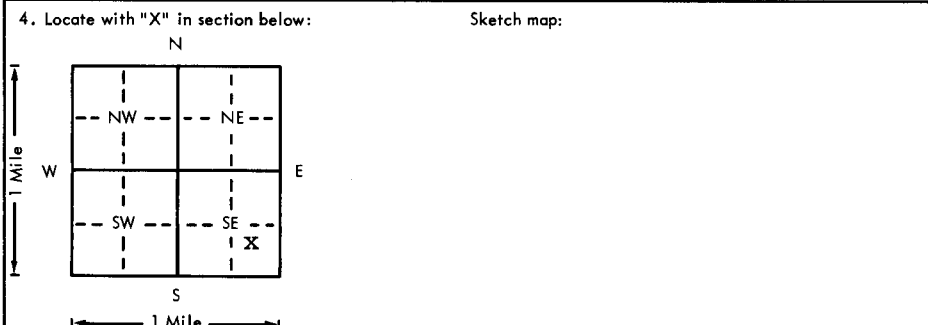

6. Bore hole dia. 30 in. Completion date 12-1-76
Well depth 299 ft.
7. Cable tool Rotary Driven Dug
 Hollow rod Jetted Bored Reverse rotary
8. Use: Domestic Public supply Industry
 Irrigation Air conditioning Stock
 Lawn Oil field water Other
9. Casing: Material Steel Height: Above or ~~xxxx~~
Threaded Welded Surface 12 in.
RMP PVC Weight .188 lbs./ft.
Dia. 16 in. to ~~192~~ 189 ft. depth Wall Thickness: inches or
Dia. 16 in. to 189 ft. depth gage No. #7

5. Type and color of material	From	To
Top Soil, Sandy Clay	0	60
Med. Coarse Sand	60	72
Coarse Sand, Med. Gravel	72	120
Coarse Sand	120	145
Med. Coarse Sand	145	152
Sandy Clay	152	154
Coarse Sand	154	159
Sandy Clay	159	162
Sandstone	162	176
Coarse Sand, Small Gravel	176	189
Sandy Clay, Sandstone	189	196
Sandy Clay, Fine Sand	196	211
Sandstone, Clay Streaks	211	220
Sandstone, Chard	220	236
Sandy Clay	236	248
Sandy Clay, Sandstone	248	256
Fine to Med. Sand	256	263
Med. Coarse Sand	263	272
Sandy Clay	272	282
Coa. Sand, Small Gravel Streaks	272	282
Med. Coa. Sand, Small Gravel Streaks	282	290
Clay Streaks	290	292
Coa. Sand, Small Med. Gravel	292	299
<i>BROOK ?</i>		

10. Screen: Manufacturer's name Brown
Type Regular Dia. 16"
Slot/gauze 10% Length 100
Set between 189 ft. and 289 ft.
10' John 289 ft. and 299 ft.
Gravel pack? Size range of material 30% #1 70% #4 x 5/8

11. Static water level: 146 ft. below land surface Date 12-3-76 mo./day/yr.
12. Pumping level below land surfaces:
296 ft. after 2 hrs. pumping 1105 g.p.m.
3 1/2 hrs. after hrs. pumping g.p.m.
Estimated maximum yield 1105 g.p.m.

13. Water sample submitted: mo./day/yr.
 Yes No Date
14. Well head completion:
 Pitless adapter 12 Inches above grade
15. Well grouted? Clay
With: Neat cement Bentonite Coarse
Depth: From 0 ft. to 10 ft.

16. Nearest source of possible contamination:
ft. 1800 Direction NE Type Farm
Well disinfected upon completion? Yes No

17. Pump: Not installed
Manufacturer's name Floway
Model number 85027 HP 200 Volts
Length of drop pipe 285 ft. capacity g.p.m.
Type:
 Submersible Turbine
 Jet Reciprocating
 Centrifugal Other

18. Elevation: Topography: Hill Slope Upland Valley
19. Remarks:

20. Water well contractor's certification:
This well was drilled under my jurisdiction and this report is true to the best of my knowledge and belief.
Western Well & Pump 245
Business name License No.
Address Box 852, Colby, KS 67701
Signed Billy Barry Date 1/6/77
Authorized representative

1-4
3-7
1-2
NE SE SE
1/4 1/4 1/4