USE TYPEWRITER OR BALL POINT PEN-PRESS FIRMLY, PRINT CLEARLY.

WATER WELL RECORD
KSA 82a-1201-1215

Kansas Department of Health and Environment-Division of Environment
(Water well Contractors)
Topeka, Kansas 66620

CCB

1. Location of well:	County	Fraction	Section number	Township number	Range number
	Cheyenne	NW 1/4 SW 1/4 SW 1/4	19	T 4 S	R 37 E/W

2. Distance and direction from nearest town or city: 4 South
Street address of well location if in city: 1 East, Bird city

3. Owner of well: Louis Sowers
R.R. or street:
City, state, zip code: Bird City, Ks, 67731

4. Locate with "X" in section below:

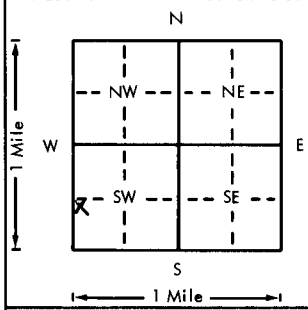

Sketch map:

6. Bore hole dia. 8 in. Completion date 6-27-78
Well depth 265 ft.

7. __ Cable tool X Rotary __ Driven __ Dug
__ Hollow rod __ Jetted __ Bored __ Reverse rotary

8. Use: __ Domestic __ Public supply __ Industry
__ Irrigation __ Air conditioning X Stock
__ Lawn __ Oil field water __ Other

9. Casing: Material Plastic Height: Above or below
Threaded ___ Welded G.I. Surface 12 in.
RMP X PVC ___ Weight ___ lbs./ft.
Dia. 5 in. to 255 ft. depth Wall Thickness: inches or
Dia. ___ in. to ___ ft. depth gage No. 230

10. Screen: Manufacturer's name J+L
Type SLOT Dia. 5
Slot/gauze 115 Length 10'
Set between 255 ft. and 265 ft.
___ ft. and ___ ft.
Gravel pack? X Size range of material 1/8

11. Static water level: mo./day/yr.
189 ft. below land surface Date 7 1978

12. Pumping level below land surfaces:
___ ft. after ___ hrs. pumping ___ g.p.m.
___ ft. after ___ hrs. pumping ___ g.p.m.
Estimated maximum yield 10 g.p.m.

13. Water sample submitted: mo./day/yr.
__ Yes X No Date

14. Well head completion:
__ Pitless adapter 12 Inches above grade

15. Well grouted? X
With: X Neat cement __ Bentonite __ Concrete
Depth: From 0 ft. to 11 ft.

16. Nearest source of possible contamination:
ft. East Direction ___ Type ___
Well disinfected upon completion? X Yes __ No

17. Pump: X Not installed
Manufacturer's name
Model number ___ HP ___ Volts ___
Length of drop pipe ___ ft. capacity ___ g.p.m.
Type:
__ Submersible __ Turbine
__ Jet __ Reciprocating
__ Centrifugal __ Other

5. Type and color of material	From	To
Top soil	0	2
Yellow Clay	2	86
Sand Rock - Clay - SDG	86	187
Rock	187	189
SDG - clay	189	211
Rock	211	212
Clay	212	241
SDG some sand stone	241	265
?		
BROCK		

(Use a second sheet if needed)

18. Elevation:
Topography:
__ Hill
__ Slope
X Upland
__ Valley

19. Remarks:

20. Water well contractor's certification:
This well was drilled under my jurisdiction and this report is true to the best of my knowledge and belief.
SCHOENROGGE DRILLING CO.
Bus. Ph. 332-2664 Res. Ph. 332-2664
ST. FRANCIS, KANSAS 67756
Business name License No. 184B
Signed Date 2-Jan-79
Authorized representative

T 4 R 37 E/W Sec 19 1/4 NW 1/4 SW 1/4 SW

Forward the white, blue and pink copies to the Department of Health and Environment

Form WWC-5