

1 LOCATION OF WATER WELL: County: Cheyenne Fraction SE 1/4 NW 1/4 NE 1/4 Section Number 26 Township Number T 4 S Range Number R 37 W EW

Distance and direction from nearest town or city street address of well if located within city?

N/A - LOCATION CONFIRMED BY GMD #4

2 WATER WELL OWNER: Charlotte Wahrman


RR#, St. Address, Box # : 203 N. 5th

City, State, ZIP Code : Atwood, KS 67730

Board of Agriculture, Division of Water Resources

Application Number:

3 LOCATE WELL'S LOCATION WITH AN "X" IN SECTION BOX:

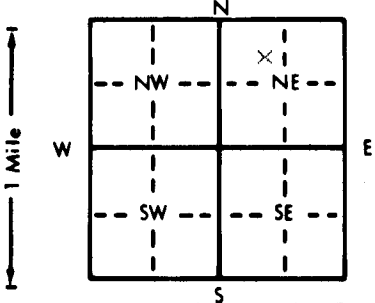

4 DEPTH OF COMPLETED WELL ..... ft. ELEVATION: .....

Depth(s) Groundwater Encountered 1. .... ft. 2. .... ft. 3. .... ft.

WELL'S STATIC WATER LEVEL ..... ft. below land surface measured on mo/day/yr

Pump test data: Well water was ..... ft. after ..... hours pumping ..... gpm

Est. Yield ..... gpm: Well water was ..... ft. after ..... hours pumping ..... gpm

Bore Hole Diameter ..... in. to ..... ft., and ..... in. to ..... ft.

- WELL WATER TO BE USED AS:
- 1 Domestic
  - 2 Irrigation
  - 3 Feedlot
  - 4 Industrial
  - 5 Public water supply
  - 6 Oil field water supply
  - 7 Lawn and garden only
  - 8 Air conditioning
  - 9 Dewatering
  - 10 Monitoring well
  - 11 Injection well
  - 12 Other (Specify below)

Was a chemical/bacteriological sample submitted to Department? Yes.....No.....; If yes, mo/day/yr sample was submitted

Water Well Disinfected? Yes No

5 TYPE OF BLANK CASING USED:

- 1 Steel
- 2 PVC
- 3 RMP (SR)
- 4 ABS

Blank casing diameter ..... in. to ..... ft., Dia ..... in. to ..... ft., Dia ..... in. to ..... ft.

Casing height above land surface ..... in., weight ..... lbs./ft. Wall thickness or gauge No. ....

TYPE OF SCREEN OR PERFORATION MATERIAL:

- 1 Steel
- 2 Brass
- 3 Stainless steel
- 4 Galvanized steel
- 5 Fiberglass
- 6 Concrete tile
- 7 PVC
- 8 RMP (SR)
- 9 ABS
- 10 Asbestos-cement
- 11 Other (specify) .....
- 12 None used (open hole)

SCREEN OR PERFORATION OPENINGS ARE:

- 1 Continuous slot
- 2 Louvered shutter
- 3 Mill slot
- 4 Key punched
- 5 Gauzed wrapped
- 6 Wire wrapped
- 7 Torch cut
- 8 Saw cut
- 9 Drilled holes
- 10 Other (specify) .....
- 11 None (open hole)

SCREEN-PERFORATED INTERVALS: From ..... ft. to ..... ft., From ..... ft. to ..... ft.

GRAVEL PACK INTERVALS: From ..... ft. to ..... ft., From ..... ft. to ..... ft.

6 GROUT MATERIAL: 1 Neat cement 2 Cement grout 3 Bentonite 4 Other

Grout Intervals: From ..... ft. to ..... ft., From ..... ft. to ..... ft., From ..... ft. to ..... ft.

What is the nearest source of possible contamination:

- 1 Septic tank
- 2 Sewer lines
- 3 Watertight sewer lines
- 4 Lateral lines
- 5 Cess pool
- 6 Seepage pit
- 7 Pit privy
- 8 Sewage lagoon
- 9 Feedyard
- 10 Livestock pens
- 11 Fuel storage
- 12 Fertilizer storage
- 13 Insecticide storage
- 14 Abandoned water well
- 15 Oil well/Gas well
- 16 Other (specify below)

Direction from well?


FROM	TO	LITHOLOGIC LOG	FROM	TO	PLUGGING INTERVALS
	ENTER				
		MAY 21 1990	25	15	Removed apex 4 ft casing
			15	6	spud
	PLUGGING		6	3	Clay
		DIVISION OF ENVIRONMENT	3	0	concrete
		INFORMATION			surface clay
		AT			
		RIGHT			

7 CONTRACTOR'S OR LANDOWNER'S CERTIFICATION: This water well was (1) constructed, (2) reconstructed, or (3) plugged under my jurisdiction and was completed on (mo/day/year) 5-5-90 and this record is true to the best of my knowledge and belief. Kansas

Water Well Contractor's License No. .... This Water Well Record was completed on (mo/day/yr) .....

under the business name of ..... by (signature) Charlotte Wahrman

well plugged by tenant Dean Knapp

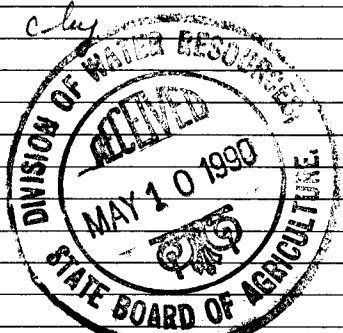

RECEIVED

OFFICE USE ONLY