


1 LOCATION OF WATER WELL:	Fraction	Section Number	Township Number	Range Number
County: Cheyenne	NE 1/4 NE 1/4 NE 1/4	1	4 S	38 W

Distance and direction from nearest town or city street address of well if located within city?

2 WATER WELL OWNER: **Bsb Construction, Inc.**
 RR#, St. Address, Box # **209 E 2nd St**
 City, State, ZIP Code : **Curtis, NE 69025-9736**
 Board of Agriculture, Division of Water Resources
 Application Number:

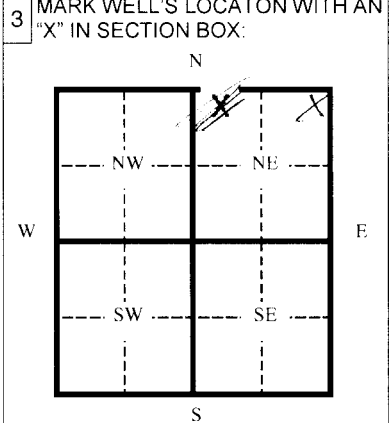

4 DEPTH OF WELL **320** ft.
 WELL'S STATIC WATER LEVEL **NA** ft.
 WELL WAS USED AS:
 1 Domestic 5 Public Water Supply 9 Dewatering
 2 Irrigation 6 Oil Field Water Supply 10 Monitoring Well
 3 Feedlot 7 Lawn and Garden (domestic) 11 Injection Well
 4 Industrial 8 Air Conditioning 12 Other **Temp Const**

Was a chemical/bacteriological sample submitted to Department? Yes ___ No x
 If yes, mo/day/yr sample was submitted _____
 Water Well Disinfected: Yes No ___

5 TYPE OF BLANK CASING USED:
 1 Steel 3 RMP (SR) 5 Wrought 7 Fiberglass 9 Other (specify below)
 2 PVC 4 ABC 6 Asbestos-Cement 8 Concrete Tile

Blank casing diameter **8** in. Was casing pulled? Yes ___ No If yes, how much _____
 Casing height above or below land surface **-36** in.

6 GROUT PLUG MATERIAL: 1 Neat cement 2 Cement grout 3 Bentonite 4 Other **Native Clay**

Grout Plug Intervals From **3** ft. to **6** ft. From **199** ft. to **202** ft. From **199** ft. to **202** ft.

What is the nearest source of possible contamination:

1 Septic tank	6 Seepage pit	11 Fuel storage	16 Other (specify below)
2 Sewer lines	7 Pit privy	12 Fertilizer storage	None
3 Watertight sewer lines	8 Sewage lagoon	13 Insecticide storage	
4 Lateral lines	9 Feedyard	14 Abandoned water well	
5 Cess Pool	10 Livestock pens	15 Oil well/ Gas well	

Direction from well? _____ How many feet? _____

FROM	TO	CODE	PLUGGING MATERIALS
0	3		Topsoil
3	6		Bentonite
6	199		Native Clay
199	202		Bentonite
202	320		Chlorinated sand

7 CONTRACTOR'S OR LANDOWNER'S CERTIFICATION: This water well was plugged under my jurisdiction and was completed on (mo/day/yr) **12/03/08** and this record is true to the best of my knowledge and belief. Kansas Water Well Contractor's License No. **554** This Water Well Record was completed on (mo/day/yr) **12/09/08** under the business name of **Woofter Pump & Well Inc.**
 by (signature) *Jay C. Woofter*

INSTRUCTIONS: Please fill in blanks and circle the correct answers. Send three copies to Kansas Department of Health and Environment, Bureau of Water, 1000 S W Jackson St., Ste. 420, Topeka, Kansas 66620-0001. Telephone: 785-296-3565. Send one to Water Well Owner and retain one for your records.