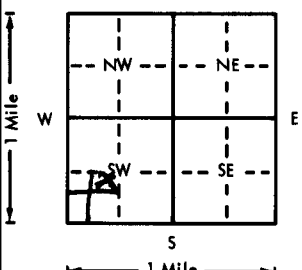


USE TYPEWRITER OR BALL
POINT PEN-PRESS FIRMLY,
PRINT CLEARLY.

WATER WELL RECORD
KA 82a-1201-1215

Kansas Department of Health and
Environment-Division of Environment
(Water well Contractors)
Topeka, Kansas 66620

1. Location of well:		County Cheyenne NE	Section SW 1/4 SW 1/4	Section number 16	Township number 4	Range number 8	E
2. Distance and direction from nearest town or city: Street address of well location if in city:				3. Owner of well: P. M. Limited R.R. or street: Dick Cannon City, state, zip code: 8811 Balston Rd. Arvada, Colo 80002			
4. Locate with "X" in section below: Sketch map: 				6. Bore hole dia. 30 in. Completion date 5/17/73 Well depth 330 ft.			
				7. <input type="checkbox"/> Cable tool <input type="checkbox"/> Rotary <input type="checkbox"/> Driven <input type="checkbox"/> Dug <input type="checkbox"/> Hollow rod <input type="checkbox"/> Jetted <input type="checkbox"/> Bored <input checked="" type="checkbox"/> Reverse rotary			
				8. Use: <input type="checkbox"/> Domestic <input type="checkbox"/> Public supply <input type="checkbox"/> Industry <input checked="" type="checkbox"/> Irrigation <input type="checkbox"/> Air conditioning <input type="checkbox"/> Stock <input type="checkbox"/> Lawn <input type="checkbox"/> Oil field water <input type="checkbox"/> Other			
				9. Casing: Material Steel Height: Above or below Threaded <input checked="" type="checkbox"/> Welded <input type="checkbox"/> Surface 12 in. RMP <input type="checkbox"/> PVC <input type="checkbox"/> Weight 32 lbs./ft. Dia. 16 in. 330 ft. depth Wall Thickness: inches or Dia. <input type="checkbox"/> in. to <input type="checkbox"/> ft. depth gage No. 7			
5. Type and color of material				From	To		
top soil - clay strips of rock				0	170		
sandy clay				170	180		
fine sand				180	190		
porous rock + sand				190	200		
4' rock 4' gravel 2' gravel				200	210		
5' porous rock 3' rock 2' gravel				210	220		
7' loose porous rock 3' gravel				220	230		
7' loose " " 3' sand				230	240		
10' loose porous rock				240	250		
10' " " "				250	260		
6' " " " 3' rock				260	270		
4' gravel 6' rock + clay				270	280		
3' rock + clay 7' gravel w/rock				280	290		
6' gravel 4' rock				290	300		
15' rock 5' gravel				300	320		
7' gravel (Use a second sheet if needed) 3' shak				320	330		
18. Elevation:		19. Remarks:		20. Water well contractor's certification:			
Topography: <input type="checkbox"/> Hill <input type="checkbox"/> Slope <input checked="" type="checkbox"/> Upland <input type="checkbox"/> Valley		BROCK 327' irrigation well		This well was drilled under my jurisdiction and this report is true to the best of my knowledge and belief. Jack Bone Drilling Inc 197 Business name Jack Bone License No. 67745 Address McDonald Ln Signed Jack Bone Date 5-17 Authorized representative			