

USE TYPEWRITER OR BALL POINT PEN-PRESS FIRMLY, PRINT CLEARLY.


WATER WELL RECORD
KSA 82a-1201-1215

Kansas Department of Health and Environment-Division of Environment
(Water well Contractors)
Topeka, Kansas 66620

COH

1. Location of well: County Cheyenne Fraction NE 1/4 SW 1/4 SW 1/4 Section number 22 Township number T 4 S R 38 E 0 Range number

2. Distance and direction from nearest town or city: 4 South 2 West of Bird City Kansas
Street address of well location if in city:
3. Owner of well: William Yeach Bird City
R.R. or street: 2
City, state, zip code: St Francis, KS 67731

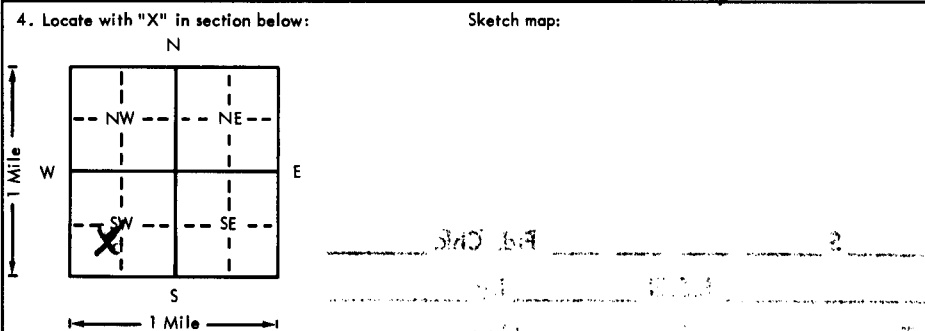

6. Bore hole dia. 20 in. Completion date 9-2-77
Well depth 320 ft.
7. Cable tool Rotary Driven Dug
 Hollow rod Jetted Bored Reverse rotary
8. Use: Domestic Public supply Industry
 Irrigation Air conditioning Stock
 Lawn Oil field water Other
9. Casing: Material Steel Weight: Above or Below
Threaded Welded Surface 72 in.
RMP 6000 Weight 2116 lbs./ft.
Dia. 16 in. to 30 ft. depth Wall Thickness: inches or
Dia. 16 in. to 30 ft. depth gage No. 188

5. Type and color of material	From	To
Top Soil	0	2
Clay	2	87
Fine Sand clay	87	100
Loose s&b	100	115
Rock	115	117
S&G SR	117	132
Rock	132	133
S&G Clay	133	146
Rock SR	146	150
S&G SR Clay	150	161
Clay s&G	161	165
S&G SR Clay	165	195
S&G	195	216
Rock	216	218
SR	218	222
Clay SR	222	225
S&G	225	246
Rock	246	248
S&G SR Clay	248	264
SR	264	265
Clay s&b	265	270
Rock	270	271
S&G SR	271	280
Clay, SR	280	283
S&G	283	297
SR	297	298
S&G	298	314
Rock	314	315
Shale	315	320

10. Screen: Manufacturer's name Coat Screen
Type Screen Dia. 16
Slot gauge 1/8" Length 10'
Set between 320 ft. and 320 ft.
240 ft. and 240 ft.
Gravel pack? Size range of material 20 to 100
11. Static water level: mo./day/yr. 196 ft. below land surface Date 7-21-77
12. Pumping level below land surfaces: 263 ft. after 10 hrs. pumping 900 g.p.m.
161 ft. after 10 hrs. pumping 900 g.p.m.
Estimated maximum yield 900 g.p.m.
13. Water sample submitted: mo./day/yr. Yes No Date
14. Well head completion: Pitless adapter 12 inches above grade
15. Well grouted?
With: Neat cement Bentonite Concrete
Depth: From 0 ft. to 10 ft.
16. Nearest source of possible contamination: ft. 1600 Direction SW Type Septic Tank
Well disinfected upon completion? Yes No
17. Pump: Not installed
Manufacturer's name Western Land Roller
Model number _____ HP _____ Volts _____
Length of drop pipe 200 ft. capacity 200 g.p.m.
Type: 10C H
 Submersible Turbine
 Jet Reciprocating
 Centrifugal Other

18. Elevation: _____
19. Remarks: BROCK 315
Topography: Hill Slope Upland Valley

20. Water well contractor's certification:
This well was drilled under my jurisdiction and this report is true to the best of my knowledge and belief.
Schoenagge Drilling Co 194A
Business name _____ License No. _____
Address St Francis, KS
Signed John Schoenagge Date 9/2/77
Authorized representative

4-38
 W
 22
 NE SW SW
 Sec
 1/4 1/4 1/4