


1] LOCATION OF WATER WELL: Fraction NE 1/4 SE 1/4 SE 1/4 Section Number 28 Township Number T 4 S Range Number R 38 W E/W
 County: Cheyenne
 Distance and direction from nearest town or city street address of well if located within city?

N/A - LOCATION CONFIRMED BY GMD #4

2] WATER WELL OWNER: Clarence Busse
 RR#, St. Address, Box #: Rt 1 Box 61 Board of Agriculture, Division of Water Resources
 City, State, ZIP Code: Bird City, KS 67731 Application Number:

3] LOCATE WELL'S LOCATION WITH AN "X" IN SECTION BOX: 4] DEPTH OF COMPLETED WELL... 165 ft. ELEVATION: ...
 Depth(s) Groundwater Encountered 1 ft. 2. ft. 3. ft.
 WELL'S STATIC WATER LEVEL . . . DRY . . . ft. below land surface measured on mo/day/yr
 Pump test data: Well water was . . . ft. after . . . hours pumping . . . gpm
 Est. Yield . . . gpm: Well water was . . . ft. after . . . hours pumping . . . gpm
 Bore Hole Diameter . . . in. to . . . ft., and . . . in. to . . . ft.
 WELL WATER TO BE USED AS: 5 Public water supply 8 Air conditioning 11 Injection well
 X1 Domestic 3 Feedlot 6 Oil field water supply 9 Dewatering 12 Other (Specify below)
 2 Irrigation 4 Industrial 7 Lawn and garden only 10 Monitoring well
 Was a chemical/bacteriological sample submitted to Department? Yes.....No.....; If yes, mo/day/yr sample was submitted
 Water Well Disinfected? Yes No

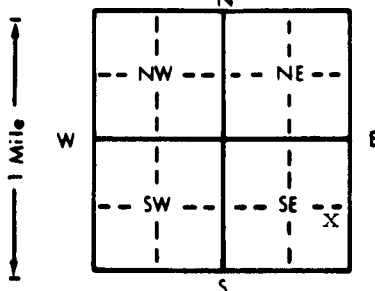

5] TYPE OF BLANK CASING USED: 5 Wrought iron 8 Concrete tile CASING JOINTS: Glued . . . Clamped . . .
 X1 Steel 3 RMP (SR) 6 Asbestos-Cement 9 Other (specify below) Welded . . .
 2 PVC 4 ABS 7 Fiberglass . . . Threaded . . .
 Blank casing diameter . . . 5 . . . in. to . . . ft., Dia . . . in. to . . . ft., Dia . . . in. to . . . ft.
 Casing height above land surface . . . 4 . . . in., weight . . . lbs./ft. Wall thickness or gauge No. . . .
 TYPE OF SCREEN OR PERFORATION MATERIAL: 7 PVC 10 Asbestos-cement
 1 Steel 3 Stainless steel 5 Fiberglass 8 RMP (SR) 11 Other (specify) . . .
 2 Brass 4 Galvanized steel 6 Concrete tile 9 ABS 12 None used (open hole)
 SCREEN OR PERFORATION OPENINGS ARE: 5 Gauzed wrapped 8 Saw cut 11 None (open hole)
 1 Continuous slot 3 Mill slot 6 Wire wrapped 9 Drilled holes
 2 Louvered shutter 4 Key punched 7 Torch cut 10 Other (specify) . . .
 SCREEN-PERFORATED INTERVALS: From . . . ft. to . . . ft., From . . . ft. to . . . ft.
 From . . . ft. to . . . ft., From . . . ft. to . . . ft.
 GRAVEL PACK INTERVALS: From . . . ft. to . . . ft., From . . . ft. to . . . ft.
 From . . . ft. to . . . ft., From . . . ft. to . . . ft.

6] GROUT MATERIAL: 1 Neat cement 2 Cement grout 3 Bentonite 4 Other . . .
 Grout intervals: From . . . 4 . . . ft. to . . . 12 . . . ft., From . . . ft. to . . . ft., From . . . ft. to . . . ft.
 What is the nearest source of possible contamination:
 1 Septic tank 4 Lateral lines 7 Pit privy 10 Livestock pens 14 Abandoned water well
 2 Sewer lines 5 Cess pool 8 Sewage lagoon 11 Fuel storage 15 Oil well/Gas well
 3 Watertight sewer lines 6 Seepage pit 9 Feedyard 12 Fertilizer storage 16 Other (specify below)
 13 Insecticide storage
 Direction from well? How many feet?

FROM	TO	LITHOLOGIC LOG	FROM	TO	PLUGGING INTERVALS
					Casing
	ENTER		165	12	Clay
			12	4	Half Plug
	PLUGGING		4	6	Clay
		INFORMATION			
		AT			
		RIGHT			

7] CONTRACTOR'S OR LANDOWNER'S CERTIFICATION: This water well was (1) constructed, (2) reconstructed, or (3) plugged under my jurisdiction and was completed on (mo/day/year) 3-1-94 and this record is true to the best of my knowledge and belief. Kansas
 Water Well Contractor's License No. 184 This Water Well Record was completed on (mo/day/yr) 3-2-94
 under the business name of Schaefer Drilling Inc by (signature) [Signature]

OFFICE USE ONLY