

USE TYPEWRITER OR BALL POINT PEN-PRESS FIRMLY, PRINT CLEARLY.

WATER WELL RECORD
KSA 82a-1201-1215

Kansas Department of Health and Environment-Division of Environment (Water well Contractors) Topeka, Kansas 66620


Job #166-77-B-14-4-37

DDA DDD

1. Location of well:	County Cheyenne	Fraction SW 1/4 SE 1/4 SE 1/4	Section number 4	Township number T 4 S R 39	Range number 39
----------------------	---------------------------	---	----------------------------	--------------------------------------	---------------------------

2. Distance and direction from nearest town or city: 2 South; 3/4 East Street address of well location if in city:	3. Owner of well: L. A. Bunjes R.R. or street: City, state, zip code: St. Francis, Kansas
---	---

4. Locate with "X" in section below: Sketch map:

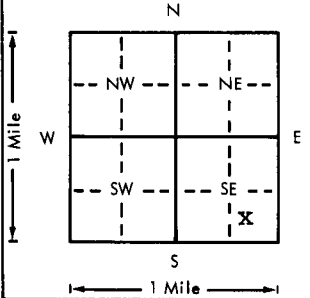

6. Bore hole dia. **30** in. Completion date **4-19-77**
Well depth **245** ft.

7. Cable tool Rotary Driven Dug
 Hollow rod Jetted Bored Reverse rotary

8. Use: Domestic Public supply Industry
 Irrigation Air conditioning Stock
 Lawn Oil field water Other

9. Casing: Material **Steel** Height: Above or below
Threaded Welded Surface **12** in.
RMP PVC Weight **.188** lbs./ft.
Dia. **16** in. to **175** ft. depth Wall Thickness: inches or
Dia. in. to ft. depth gage No. **#7**

5. Type and color of material	From	To
Clay	0	63
Sand, Gravel, Sandstone	63	106
Fine Med. Sand, Sandstone Streaks	106	117
Clay	117	123
Fine Med. Sand, Sandstone Streaks	123	173
Sandy Clay, Cemented	173	195
Fine Coarse Sand	195	206
Clay	206	209
Fine Coarse Sand, Cemented	209	215
Coarse Sand, Gravel	215	222
Coarse Sand, Sandstone Streaks	222	227
Coarse Sand, Gravel	227	239
Shale	239	245
(Use a second sheet if needed)		

10. Screens: Manufacturer's name
Brown

Type **Bridge** Dia. **16"**
Slot/gauze **10%** Length **60'**
Set between **175** ft. and **235** ft.
10' Cook ft. and **245** ft.
Gravel pack? Size range of material **5/8 x 1/2**

11. Static water level: mo./day/yr.
141 ft. below land surface Date **4-30-77**

12. Pumping level below land surfaces:
215 ft. after **2** hrs. pumping **1050** g.p.m.
ft. after _____ hrs. pumping _____ g.p.m.
Estimated maximum yield **1050** g.p.m.

13. Water sample submitted: mo./day/yr.
Yes No Date _____

14. Well head completion:
 Pitless adapter _____ **12** inches above grade

15. Well grouted? **CLAY**
With: Neat cement Bentonite **XXXXXX**
Depth: From **0** ft. to **10** ft.

16. Nearest source of possible contamination:
ft. **1320** Direction **NE** Type **House**
Well disinfected upon completion? Yes No

17. Pump: Not installed
Manufacturer's name **Floway**
Model number **85319** HP **100** Volts **480**
Length of drop pipe **230** ft. capacity **700** g.p.m.
Type: **13 Stage 10" DOH**
 Submersible Turbine
 Jet Reciprocating
 Centrifugal Other

18. Elevation:	19. Remarks: 246 400'
Topography: <input type="checkbox"/> Hill <input type="checkbox"/> Slope <input checked="" type="checkbox"/> Upland <input type="checkbox"/> Valley	

20. Water well contractor's certification:
This well was drilled under my jurisdiction and this report is true to the best of my knowledge and belief.
Western Well & Pump **245**
Business name License No.
Address: **Box 852, Colby, KS 67701**
Signed: **Sally Berry** Date: **10/27/77**
Authorized representative

1-77
 R 390
 Sec 4 NW SE SE
 1/4 1/4 1/4