


USE TYPEWRITER OR BALL POINT PEN-PRESS FIRMLY, PRINT CLEARLY.

WATER WELL RECORD
KSA 82a-1201-1215

Kansas Department of Health and Environment-Division of Environment (Water well Contractors) Topeka, Kansas 66620

1. Location of well: County Cheyenne Fraction SE 1/4 SW 1/4 NE 1/4 Section number 14 Township number 4 S 4 R 39 E/W

2. Distance and direction from nearest town or city: 7 East 4 South 3. Owner of well: Otto Bunjes
Street address of well location if in city: 0 E ST. FRANCIS R.R. or street:
City, state, zip code: St. Francis, KS 67756

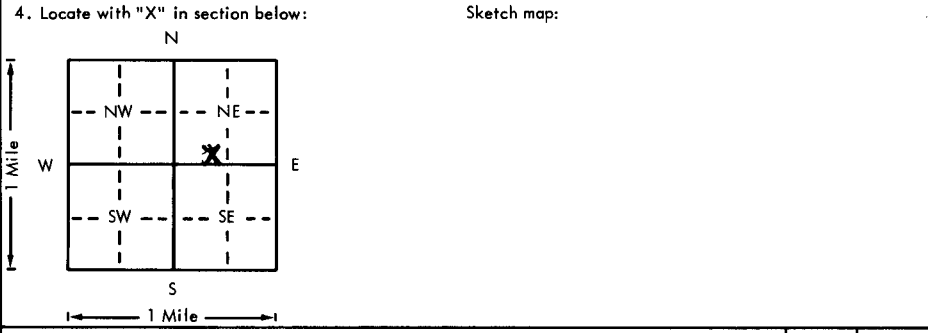

6. Bore hole dia. 5.8 in. Completion date 7/16/79
Well depth 220 ft.
7. Cable tool Rotary Driven Dug
 Hollow rod Jetted Bored Reverse rotary
8. Use: Domestic Public supply Industry
 Irrigation Air conditioning Stock
 Lawn Oil field water Other
9. Casing: Material plastic Height: Above or below
Threaded Welded 66 Surface 12 in.
RMP PVC Weight lbs./ft.
Dia. 5 in. to 210 ft. depth Wall Thickness: inches or
Dia. in. to ft. depth gauge No. 250

5. Type and color of material	From	To
<u>Top soil</u>	<u>0</u>	<u>2</u>
<u>clay</u>	<u>2</u>	<u>49</u>
<u>Rock-clay- ssg</u>	<u>49</u>	<u>146</u>
<u>Rock</u>	<u>146</u>	<u>148</u>
<u>Sand with Rock layers</u>	<u>148</u>	<u>161</u>
<u>Rock</u>	<u>161</u>	<u>162</u>
<u>ssg-clay</u>	<u>162</u>	<u>179</u>
<u>clay</u>	<u>179</u>	<u>188</u>
<u>Rock</u>	<u>188</u>	<u>189</u>
<u>ssg</u>	<u>189</u>	<u>220</u>

10. Screen: Manufacturer's name J+L
Type Slot Dia. 5
Slot/gauze 115 Length 10
Set between 210 ft. and 220 ft.
ft. and ft.
Gravel pack? Size range of material 1/8
11. Static water level: mo./day/yr.
149 ft. below land surface Date 7 7 79
12. Pumping level below land surfaces:
 ft. after hrs. pumping g.p.m.
 ft. after hrs. pumping g.p.m.
Estimated maximum yield 10 g.p.m.
13. Water sample submitted: mo./day/yr.
Yes No Date
14. Well head completion:
 Pitless adapter 12 Inches above grade
15. Well grouted?
With: Neat cement Bentonite Concrete
Depth: From 0 ft. to 10 ft.
16. Nearest source of possible contamination:
ft. Post hole Type
Well disinfected upon completion? Yes No
17. Pump: Not installed
Manufacturer's name A
Model number HP Volts
Length of drop pipe ft. capacity g.p.m.
Type:
 Submersible Turbine
 Jet Reciprocating
 Centrifugal Other

18. Elevation: Topography: Hill Slope Upland Valley
19. Remarks:

20. Water well contractor's certification:
This well was drilled under my jurisdiction and this report is true to the best of my knowledge and belief.
SCHNEIDER ENGINEERING CO. 184 B
Business name License No.
Bus. Ph. 302 Address E. S. Ph 322 2444
ST. FRANCIS, KANSAS Date 7/22/79
Authorized representative

T 4 39 E 14 SE SW NE 1/4 1/4 1/4