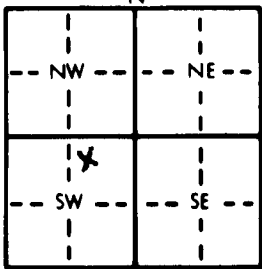


1 LOCATION OF WATER WELL: Fraction NE 1/4 SW 1/4 SW 1/4 Section Number 17 Township Number T 4 S Range Number R 39 E/W

Distance and direction from nearest town or city street address of well if located within city?  
 N/A - LOCATION CONFIRMED BY GND 4

2 WATER WELL OWNER: D & D FARMS  
 RR#, St. Address, Box # : c/o RICHARD DANIELS Board of Agriculture, Division of Water Resources  
 City, State, ZIP Code : ST. FRANCIS, KS 67756 Application Number: N/A


3 LOCATE WELL'S LOCATION WITH AN "X" IN SECTION BOX:  
  
 4 DEPTH OF COMPLETED WELL...UNK... ft. ELEVATION: ... ft.  
 Depth(s) Groundwater Encountered 1... ft. 2... ft. 3... ft.  
 WELL'S STATIC WATER LEVEL... DRY... ft. below land surface measured on mo/day/yr  
 Pump test data: Well water was ... ft. after ... hours pumping ... gpm  
 Est. Yield ... gpm: Well water was ... ft. after ... hours pumping ... gpm  
 Bore Hole Diameter... in. to ... ft., and ... in. to ... ft.  
 WELL WATER TO BE USED AS:  
 (1) Domestic 3 Feedlot 6 Oil field water supply 9 Dewatering 12 Other (Specify below)  
 2 Irrigation 4 Industrial 7 Lawn and garden only 10 Monitoring well  
 Was a chemical/bacteriological sample submitted to Department? Yes.....No.....; If yes, mo/day/yr sample was submitted  
 Water Well Disinfected? Yes No

5 TYPE OF BLANK CASING USED:  
 X Steel 3 RMP (SR) 5 Wrought iron 8 Concrete tile CASING JOINTS: Glued... Clamped...  
 2 PVC 4 ABS 6 Asbestos-Cement 9 Other (specify below) Welded...  
 7 Fiberglass Threaded...  
 Blank casing diameter... 4" in. to ... ft., Dia ... in. to ... ft., Dia ... in. to ... ft.  
 Casing height above land surface... in., weight ... lbs./ft. Wall thickness or gauge No. ...  
 TYPE OF SCREEN OR PERFORATION MATERIAL:  
 1 Steel 3 Stainless steel 5 Fiberglass 7 PVC 10 Asbestos-cement  
 2 Brass 4 Galvanized steel 6 Concrete tile 9 ABS 11 Other (specify) ...  
 12 None used (open hole)  
 SCREEN OR PERFORATION OPENINGS ARE:  
 1 Continuous slot 3 Mill slot 5 Gauzed wrapped 8 Saw cut 11 None (open hole)  
 2 Louvered shutter 4 Key punched 6 Wire wrapped 9 Drilled holes  
 7 Torch cut 10 Other (specify) ...  
 SCREEN-PERFORATED INTERVALS: From ... ft. to ... ft., From ... ft. to ... ft.  
 From ... ft. to ... ft., From ... ft. to ... ft.  
 GRAVEL PACK INTERVALS: From ... ft. to ... ft., From ... ft. to ... ft.  
 From ... ft. to ... ft., From ... ft. to ... ft.

6 GROUT MATERIAL: 1 Neat cement 2 Cement grout (3) Bentonite 4 Other ...  
 Grout Intervals: From ... 7' ... ft. to ... 4' ... ft., From ... ft. to ... ft., From ... ft. to ... ft.  
 What is the nearest source of possible contamination:  
 1 Septic tank 4 Lateral lines 7 Pit privy 10 Livestock pens 14 Abandoned water well  
 2 Sewer lines 5 Cess pool 8 Sewage lagoon 11 Fuel storage 15 Oil well/Gas well  
 3 Watertight sewer lines 6 Seepage pit 9 Feedyard 12 Fertilizer storage 16 Other (specify below)  
 13 Insecticide storage ... NONE

Direction from well? How many feet?

FROM	TO	LITHOLOGIC LOG	FROM	TO	PLUGGING INTERVALS
			BOTTOM - 7'		CLAY / DIRT
			7'	4'	BENTONITE GROUT
			4'	0'	SURFACE BACKFILL

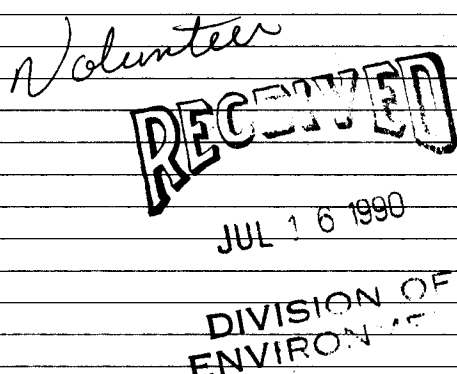

7 CONTRACTOR'S OR LANDOWNER'S CERTIFICATION: This water well was (1) constructed, (2) reconstructed, or (3) plugged under my jurisdiction and was completed on (mo/day/year) June 7, 1990 and this record is true to the best of my knowledge and belief. Kansas Water Well Contractor's License No. This Water Well Record was completed on (mo/day/yr) by (signature) R. Richard Daniels under the business name of D & D Farms, Inc.

OFFICE USE ONLY