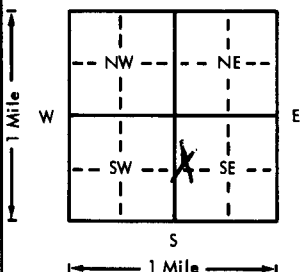


USE TYPEWRITER OR BALL POINT PEN-PRESS FIRMLY, PRINT CLEARLY.

WATER WELL RECORD
KSA 82a-1201-1215

Kansas Department of Health and Environment-Division of Environment (Water well Contractors) Topeka, Kansas 66620

DRC

1. Location of well:	County: <u>Cherokee</u>	Fraction: <u>SW 1/4 NW 1/4 SE 1/4</u>	Section number: <u>18</u>	Township number: <u>T 39 4 S</u>	Range number: <u>R # 39 E (D)</u>
2. Distance and direction from nearest town or city: <u>4 1/2 mi W</u> Street address of well location if in city: <u>Wheeler, Ks</u>			3. Owner of well: <u>Murfin Drilling Co.</u> R.R. or street: City, state, zip code: <u>Wichita, Ks</u>		
4. Locate with "X" in section below: N W E S 1 Mile			Sketch map: 		
5. Type and color of material			From	To	6. Bore hole dia. <u>3</u> in. Completion date: <u>2-1-78</u> Well depth: <u>260</u> ft.
<u>Top soil</u>			<u>0</u>	<u>5</u>	7. <input checked="" type="checkbox"/> Cable tool <input checked="" type="checkbox"/> Rotary <input type="checkbox"/> Driven <input type="checkbox"/> Dug <input type="checkbox"/> Hollow rod <input type="checkbox"/> Jetted <input type="checkbox"/> Bored <input type="checkbox"/> Reverse rotary
<u>clay</u>			<u>5</u>	<u>120</u>	8. Use: <input type="checkbox"/> Domestic <input type="checkbox"/> Public supply <input type="checkbox"/> Industry <input type="checkbox"/> Irrigation <input type="checkbox"/> Air conditioning <input type="checkbox"/> Stock <input type="checkbox"/> Lawn <input checked="" type="checkbox"/> Oil field water <input type="checkbox"/> Other
<u>sand + clay</u>			<u>120</u>	<u>230</u>	9. Casing: Material <u>PVC</u> Height: Above or below Threaded <input type="checkbox"/> Welded <input checked="" type="checkbox"/> Surface <u>24</u> in. RMP <input type="checkbox"/> PVC <input checked="" type="checkbox"/> Weight <u>200</u> lbs./ft. Dia. <u>5</u> in. to <u>260</u> ft. depth Wall Thickness: inches or Dia. <u> </u> in. to <u> </u> ft. depth gage No. <u>26</u>
<u>sand</u>			<u>230</u>	<u>260</u>	10. Screen: Manufacturer's name <u>Jet Stream</u> Type <u>PVC</u> Dia. <u>5"</u> Slot gauze <u>.021</u> Length <u>20'</u> Set between <u>240</u> ft. and <u>260</u> ft. <u> </u> ft. and <u> </u> ft. Gravel pack? <input checked="" type="checkbox"/> Size range of material <u>1/4 to 1/2</u>
<u>BROCK ?</u>					11. Static water level: <u>160</u> ft. below land surface Date <u>2-1-78</u> mo./day/yr.
					12. Pumping level below land surfaces: <u>180</u> ft. after <u>2</u> hrs. pumping <u>40</u> g.p.m. <u> </u> ft. after <u> </u> hrs. pumping <u> </u> g.p.m. Estimated maximum yield <u>40</u> g.p.m.
					13. Water sample submitted: <u> </u> mo./day/yr. Yes <input checked="" type="checkbox"/> No <input type="checkbox"/> Date <u> </u>
					14. Well head completion: <input type="checkbox"/> Pitless adapter <u>24</u> Inches above grade
					15. Well grouted? <input checked="" type="checkbox"/> With: <input type="checkbox"/> Neat cement <input type="checkbox"/> Bentonite <input checked="" type="checkbox"/> Concrete Depth: From <u>0</u> ft. to <u>10</u> ft.
					16. Nearest source of possible contamination: <u>oil well</u> ft. <u>500</u> Direction <u>S</u> Type <u>oil well</u> Well disinfected upon completion? <input type="checkbox"/> Yes <input checked="" type="checkbox"/> No
					17. Pump: <input type="checkbox"/> Not installed Manufacturer's name <u>Fairbanks</u> Model number <u>UK</u> HP <u>5</u> Volts <u>230</u> Length of drop pipe <u>220</u> ft. capacity <u>50</u> g.p.m. Type: <input checked="" type="checkbox"/> Submersible <input type="checkbox"/> Turbine <input type="checkbox"/> Jet <input type="checkbox"/> Reciprocating <input type="checkbox"/> Centrifugal <input type="checkbox"/> Other
(Use a second sheet if needed)					
18. Elevation:	19. Remarks:		20. Water well contractor's certification: This well was drilled under my jurisdiction and this report is true to the best of my knowledge and belief. <u>Scott Water Well Inc</u> Business name License No. <u> </u> Address <u>Highway 40 Hays</u> Signed <u> </u> Authorized representative Date <u>2-1-78</u>		
Topography: <input type="checkbox"/> Hill <input type="checkbox"/> Slope <input checked="" type="checkbox"/> Upland <input type="checkbox"/> Valley					

4-39 E 18 SE QUARTER