

USE TYPEWRITER OR BALL POINT PEN-PRESS FIRMLY, PRINT CLEARLY.


WATER WELL RECORD  
KSA 82a-1201-1215

Kansas Department of Health and Environment-Division of Environment (Water well Contractors) Topeka, Kansas 66620

*AAID*

1. Location of well: County Cheyenne Fraction SE 1/4 NE 1/4 NE 1/4 Section number 31 Township number T 41 S Range number R 39 E/W

2. Distance and direction from nearest town or city: 6 South West 1/4 South Wheeler, Kan  
Street address of well location if in city:  
3. Owner of well: Tri State Feeders  
R.R. or street:  
City, state, zip code: St. Francis, KS 67756

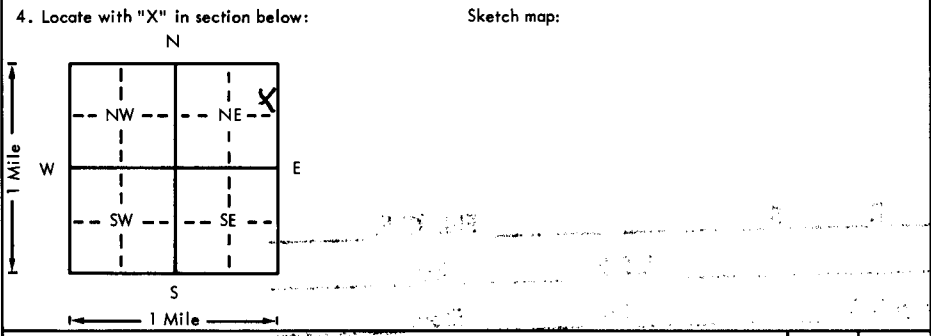

6. Bore hole dia. 5 in. Completion date 1-19-77  
Well depth 228 ft.  
7.  Cable tool  Rotary  Driven  Dug  
 Hollow rod  Jetted  Bored  Reverse rotary  
8. Use:  Domestic  Public supply  Industry  
 Irrigation  Air conditioning  Stock  
 Lawn  Oil field water  Other  
9. Casing: Material PLASTIC Height: Above or below  
Threaded  Welded GL Surface 12 in.  
RMP  PVC Weight  lbs./ft.  
Dia. 5 in. to 218 ft. depth Wall Thickness: inches or  
Dia.  in. to  ft. depth gage No. 250

5. Type and color of material	From	To
<u>Top soil</u>	<u>0</u>	<u>2</u>
<u>Yellow clay</u>	<u>2</u>	<u>53</u>
<u><del>SBG</del> - Clay - SBG - Rock</u>	<u>57</u>	<u>149</u>
<u>Rock</u>	<u>149</u>	<u>151</u>
<u>SBG</u>	<u>151</u>	<u>163</u>
<u>Rock</u>	<u>163</u>	<u>165</u>
<u>SBG</u>	<u>165</u>	<u>189</u>
<u>Rock</u>	<u>189</u>	<u>193</u>
<u>SBG - clay</u>	<u>193</u>	<u>223</u>
<u>Rock</u>	<u>223</u>	<u>228</u>
<u>BROCK ?</u>		

10. Screen: Manufacturer's name J & L  
Type SLOT Dia. 5  
Slot/gauze 115 Length 10'  
Set between: 218 ft. and 228 ft.  
ft. and  ft.  
Gravel pack?  Size range of material 18  
11. Static water level: 156 ft. below land surface Date May 6 1977 mo./day/yr.  
12. Pumping level below land surfaces:  
 ft. after  hrs. pumping  g.p.m.  
 ft. after  hrs. pumping  g.p.m.  
Estimated maximum yield 60 g.p.m.  
13. Water sample submitted:  Yes  No Date \_\_\_\_\_ mo./day/yr.  
14. Well head completion:  
 Pitless adapter 12 Inches above grade  
15. Well grouted?   
With:  Neat cement  Bentonite  Concrete  
Depth: From 0 ft. to 11 ft.  
16. Nearest source of possible contamination:  
ft. 450 Direction West Type Stock Ponds  
Well disinfected upon completion?  Yes  No  
17. Pump:  Not installed  
Manufacturer's name Permotor  
Model number \_\_\_\_\_ HP 5 HP Volts 230  
Length of drop pipe 215 ft. capacity 50 g.p.m.  
Type:  
 Submersible  Turbine  
 Jet  Reciprocating  
 Centrifugal  Other

18. Elevation: Topography:  Hill  Slope  Upland  Valley  
19. Remarks:  
20. Water well contractor's certification:  
This well was drilled under my jurisdiction and this report is true to the best of my knowledge and belief.  
**SCHONVILLE DRILLING CO.**  
Bus. Ph. 332-2664 R.s. Ph. 332-2664 184B  
Business name **ST. FRANCIS, KANSAS 67788** License No. \_\_\_\_\_  
Signed [Signature] Date 2/2/77  
Authorized representative

T 41 S R 39 E SE 1/4 NE 1/4