


1 LOCATION OF WATER WELL: County: Republic Fraction 1/4 1/4 SW 1/4 Section Number 8 Township Number T 4 S Range Number R 4 EW

Distance and direction from nearest town or city street address of well if located within city?

2 WATER WELL OWNER: LARRY LARSON
 RR#, St. Address, Box #: RR 2, Box 66
 City, State, ZIP Code: Scandia, KS 66966
 Board of Agriculture, Division of Water Resources
 Application Number: 1.1.620

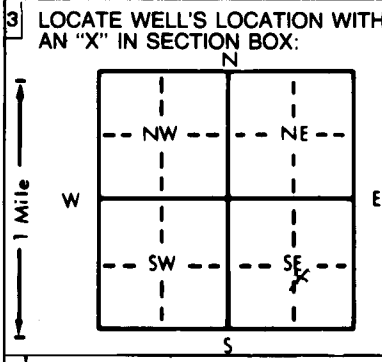

4 DEPTH OF COMPLETED WELL: 60 ft. ELEVATION:
 Depth(s) Groundwater Encountered 1. 11 ft. 2. ft. 3. ft.
 WELL'S STATIC WATER LEVEL: 37.11 ft. below land surface measured on mo/day/yr
 Pump test data: Well water was 7.31 ft. after 6 hours pumping 700 gpm
 Est. Yield 700 gpm: Well water was ft. after hours pumping gpm
 Bore Hole Diameter: 30 in. to ft., and in. to ft.
 WELL WATER TO BE USED AS:
 1 Domestic 2 Irrigation 3 Feedlot 4 Industrial 5 Public water supply 6 Oil field water supply 7 Lawn and garden only 8 Air conditioning 9 Dewatering 10 Monitoring well 11 Injection well 12 Other (Specify below)
 Was a chemical/bacteriological sample submitted to Department? Yes No X; If yes, mo/day/yr sample was submitted
 Water Well Disinfected? Yes X No

5 TYPE OF BLANK CASING USED:
 1 Steel 2 PVC 3 RMP (SR) 4 ABS 5 Wrought iron 6 Asbestos-Cement 7 Fiberglass 8 Concrete tile 9 Other (specify below) CASING JOINTS: Glued Clamped Welded Threaded
 Blank casing diameter 16 in. to 20 ft., Dia. in. to ft., Dia. in. to ft.
 Casing height above land surface in., weight Sch. 40 lbs./ft. Wall thickness or gauge No.
 TYPE OF SCREEN OR PERFORATION MATERIAL:
 1 Steel 2 Brass 3 Stainless steel 4 Galvanized steel 5 Fiberglass 6 Concrete tile 7 RMP (SR) 8 ABS 9 Asbestos-cement 10 Asbestos-cement 11 Other (specify) Double Slot 12 None used (open hole)
 SCREEN OR PERFORATION OPENINGS ARE:
 1 Continuous slot 2 Louvered shutter 3 Mill slot 4 Key punched 5 Gauzed wrapped 6 Wire wrapped 7 Torch cut 8 Saw cut 9 Drilled holes 10 Other (specify) 11 None (open hole)
 SCREEN-PERFORATED INTERVALS: From 20 ft. to 60 ft., From ft. to ft., From ft. to ft., From ft. to ft.
 GRAVEL PACK INTERVALS: From 60 ft. to 10 ft., From ft. to ft., From ft. to ft., From ft. to ft.

6 GROUT MATERIAL: 1 Neat cement 2 Cement grout 3 Bentonite 4 Other
 Grout Intervals: From 10 ft. to 0 ft., From ft. to ft., From ft. to ft., From ft. to ft.
 What is the nearest source of possible contamination:
 1 Septic tank 2 Sewer lines 3 Watertight sewer lines 4 Lateral lines 5 Cess pool 6 Seepage pit 7 Pit privy 8 Sewage lagoon 9 Feedyard 10 Livestock pens 11 Fuel storage 12 Fertilizer storage 13 Insecticide storage 14 Abandoned water well 15 Oil well/Gas well 16 Other (specify below)
 Direction from well? NORTH EAST How many feet? 200

FROM	TO	LITHOLOGIC LOG	FROM	TO	PLUGGING INTERVALS
0	5	Sandy top soil			
5	10	Fine sand			
10	18	Med. Gravel			
18	23	Blue, Med. Gravel			
23	25	Blue Med. Gravel, clay layer			
25	42	Blue Med. Gravel			
42	43	Blue clay			
43	44	Light Brown clay			
44	45	Fine sand			
45	48	Med. sand			
48	49	Blue clay layer, sandy			
49	53	Blue, med Gravel			
53	55	Sandy, Blue clay			
55	60	Blue clay			

7 CONTRACTOR'S OR LANDOWNER'S CERTIFICATION: This water well was (1) constructed, (2) reconstructed, or (3) plugged under my jurisdiction and was completed on (mo/day/year) 6/9/95 and this record is true to the best of my knowledge and belief. Kansas Water Well Contractor's License No. 480 This Water Well Record was completed on (mo/day/yr) 6/23/95 under the business name of WILLIAMS DRILLING INC. by (signature) [Signature]