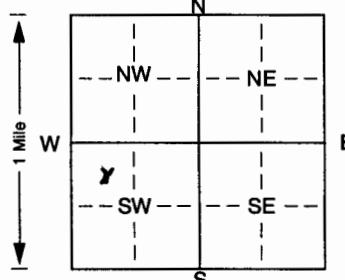


1 LOCATION OF WATER WELL: Fraction SE 1/4 NW 1/4 SW 1/4 Section Number 17 Township Number T 4 S Range Number R 4 E/W
 County: Republic

Distance and direction from nearest town or city street address of well if located within city?
1 Mile West of Norway

2 WATER WELL OWNER: Rod Zohn
 RR#, St. Address, Box #: 435 80 Road Board of Agriculture, Division of Water Resources
 City, State, ZIP Code: Jamesstown, KS 66948 Application Number:

3 LOCATE WELL'S LOCATION WITH AN "X" IN SECTION BOX:

 4 DEPTH OF COMPLETED WELL: 60 ft. ELEVATION:
 Depth(s) Groundwater Encountered: 1. 38 ft. 2. 40 ft. 3. 45 ft.
 WELL'S STATIC WATER LEVEL: 38 ft. below land surface measured on mo/day/yr 11-3-06
 Pump test data: Well water was _____ ft. after _____ hours pumping _____ gpm
 Est. Yield 5 gpm: Well water was _____ ft. after _____ hours pumping _____ gpm
 Bore Hole Diameter: 10 in. to 60 ft., and _____ in. to _____ ft.
 WELL WATER TO BE USED AS:
 Domestic 3 Feedlot 6 Oil field water supply 9 Dewatering 12 Other (Specify below)
 2 Irrigation 4 Industrial 7 Domestic (lawn & garden) 10 Monitoring well
 Was a chemical/bacteriological sample submitted to Department? Yes. _____ No. X; If yes, mo/day/yr sample was submitted
 Water Well Disinfected? Yes X No

5 TYPE OF BLANK CASING USED:
 1 Steel 3 RMP (SR) 6 Asbestos-Cement 9 Other (specify below) CASING JOINTS: Glued. X Clamped. _____
 2 PVC 4 ABS 7 Fiberglass _____ Threaded. _____
 Blank casing diameter 5 in. to 35 ft., Dia _____ in. to _____ ft., Dia _____ in. to _____ ft.
 Casing height above land surface 18 in., weight 2.893 lbs./ft. Wall thickness or gauge No. 245
 TYPE OF SCREEN OR PERFORATION MATERIAL:
 1 Steel 3 Stainless steel 5 Fiberglass 7 PVC 10 Asbestos-cement
 2 Brass 4 Galvanized steel 6 Concrete tile 8 RMP (SR) 11 Other (specify) _____
 12 None used (open hole)
 SCREEN OR PERFORATION OPENINGS ARE:
 1 Continuous slot 3 Mill slot 5 Gauzed wrapped 8 Saw cut 11 None (open hole)
 2 Louvered shutter 4 Key punched 6 Wire wrapped 9 Drilled holes
 7 Torch cut 10 Other (specify) _____ ft.
 SCREEN-PERFORATED INTERVALS: From 35 ft. to 60 ft., From _____ ft. to _____ ft.
 GRAVEL PACK INTERVALS: From 13 ft. to 60 ft., From _____ ft. to _____ ft.

6 GROUT MATERIAL: 1 Neat cement 2 Cement grout 3 Bentonite 4 Other _____
 Grout Intervals: From 3 ft. to 13 ft., From _____ ft. to _____ ft., From _____ ft. to _____ ft.
 What is the nearest source of possible contamination: none
 1 Septic tank 4 Lateral lines 7 Pit privy 10 Livestock pens 14 Abandoned water well
 2 Sewer lines 5 Cess pool 8 Sewage lagoon 11 Fuel storage 15 Oil well/Gas well
 3 Watertight sewer lines 6 Seepage pit 9 Feedyard 12 Fertilizer storage 16 Other (specify below)
 Direction from well? _____ How many feet? _____

FROM	TO	LITHOLOGIC LOG	FROM	TO	PLUGGING INTERVALS
0	5	Top Soil			
5	25	Tan Clay			
25	30	Tan Clay Mixed w/ Sand & Gravel			
30	35	Coarse Sand & Medium Gravel			
35	40	Coarse Sand - Medium Gravel with Clay & Gray Shale Layers			
40	45	Blue Clay Mix w/ Gray Shale			
45	55	Blue Clay & Fine Blue Sand with some Limestone mix			
55	60	Soft Limestone			

7 CONTRACTOR'S OR LANDOWNER'S CERTIFICATION: This water well was (1) constructed, (2) reconstructed, or (3) plugged under my jurisdiction and was completed on (mo/day/year) 11-3-06 and this record is true to the best of my knowledge and belief. Kansas Water Well Contractor's Licence No. 480 This Water Well Record was completed on (mo/day/yr) 11-17-06 under the business name of Williams Drilling Co Inc by (signature) Ron Williams