

WATER WELL RECORD


Form WWC-5

Division of Water Resources App. No.

Blank box for application number

1 LOCATION OF WATER WELL: County: Republic, Fraction: SW 1/4 SE 1/4 NE 1/4 NE 1/4, Section Number: 8, Township No.: T 4 S, Range Number: R 4, Global Positioning System (GPS) information: Latitude: 39.7231940, Longitude: 97.783550, Elevation: ... Datum: NAD 83, Collection Method: Handheld GPS unit

2 WATER WELL OWNER: Warren Sutton, RR#: 110 Nelson Ave, City, State, ZIP Code: Norway, KS 66961

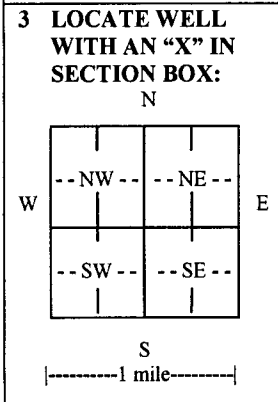

3 LOCATE WELL WITH AN 'X' IN SECTION BOX: ... 4 DEPTH OF COMPLETED WELL 60 ft. Depth(s) Groundwater Encountered (1) 10 ft. (2) ... ft. (3) ... ft. WELL'S STATIC WATER LEVEL 10 ft. below land surface measured on mo/day/yr. 05/23/12. Pump test data: Well water was ... ft. after ... hours pumping ... gpm. EST. YIELD 800 gpm. Well water was 17 ft. after 2 hours pumping 800 gpm. Bore Hole Diameter 30 in. to 60 ft. and ... in. to ... ft. WELL WATER TO BE USED AS: Domestic, Irrigation, Industrial, etc.

5 TYPE OF CASING USED: PVC, CASING JOINTS: Glued, Casing diameter 16 in. to 20 ft., Casing height above land surface ... in., TYPE OF SCREEN OR PERFORATION MATERIAL: PVC, SCREEN OR PERFORATION OPENINGS ARE: Continuous slot, SCREEN-PERFORATED INTERVALS: From 20 ft. to 60 ft., GRAVEL PACK INTERVALS: From 20 ft. to 60 ft.

6 GROUT MATERIAL: Bentonite, Grout Intervals: From 0 ft. to 20 ft., What is the nearest source of possible contamination: Abandoned water well

Table with columns: FROM, TO, LITHOLOGIC LOG, FROM, TO, LITHO. LOG (cont.) or PLUGGING INTERVALS. Rows show soil layers: Topsoil (0-5), Sandy (5-16), Gravel (16-42), Clay (42-54), Sand (54-60).

7 CONTRACTOR'S OR LANDOWNER'S CERTIFICATION: This water well was constructed, reconstructed, or plugged under my jurisdiction and was completed on (mo/day/year) 05/23/2012. Kansas Water Well Contractor's License No. 755. This Water Well Record was completed on (mo/day/year) 10/02/2012 under the business name of Sargent Drilling by (signature) [Signature]

INSTRUCTIONS: Use typewriter or ball point pen. PLEASE PRESS FIRMLY and PRINT clearly. Please fill in blanks and check the correct answers. Send three copies (white, blue, pink) to Kansas Department of Health and Environment, Bureau of Water, Geology Section, 1000 SW Jackson St., Suite 420, Topeka, Kansas 66612-1367. Telephone 785-296-5524. Send one copy to WATER WELL OWNER and retain one for your records. I include fee of \$5.00 for each constructed well. Visit us at http://www.kdheks.gov/waterwell/index.html.