

WATER WELL RECORD Form WWC-5 KSA 82a-1212


1) LOCATION OF WATER WELL: County: Republic Fraction SW 1/4 SE 1/4 SE 1/4 Section Number 8 Township Number T 4 S Range Number R 4 E/W

Distance and direction from nearest town or city street address of well if located within city?

6 Miles South Scandia

2) WATER WELL OWNER: LARRY LARSON RR#, St. Address, Box #: RR 2 City, State, ZIP Code: SCANDIA, KANSAS 66966 Board of Agriculture, Division of Water Resources Application Number: 4598

3) LOCATE WELL'S LOCATION WITH AN "X" IN SECTION BOX:

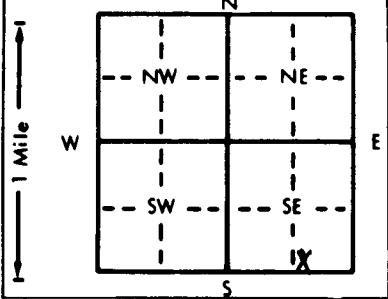

4) DEPTH OF COMPLETED WELL: 60 ft. ELEVATION:

Depth(s) Groundwater Encountered: 1. ft. 2. ft. 3. ft. WELL'S STATIC WATER LEVEL: 15 ft. below land surface measured on mo/day/yr Pump test data: Well water was... ft. after... hours pumping... gpm Est. Yield: 950 gpm Bore Hole Diameter: 30 in. to 60 in. and... in. to... ft. WELL WATER TO BE USED AS: 1 Domestic, 2 Irrigation, 3 Feedlot, 4 Industrial, 5 Public water supply, 6 Oil field water supply, 7 Lawn and garden only, 8 Air conditioning, 9 Dewatering, 10 Monitoring well, 11 Injection well, 12 Other (Specify below) Was a chemical/bacteriological sample submitted to Department? Yes... No X... If yes, mo/day/yr sample was submitted Water Well Disinfected? Yes... No X

5) TYPE OF BLANK CASING USED: 1 Steel, 2 PVC, 3 RMP (SR), 4 ABS, 5 Wrought iron, 6 Asbestos-Cement, 7 Fiberglass, 8 Concrete tile, 9 Other (specify below) CASING JOINTS: Glued X, Clamped, Welded, Threaded

Blank casing diameter: 16 in. to 40 in. Dia in. to... ft., Dia in. to... ft. Casing height above land surface... in., weight... lbs./ft. Wall thickness or gauge No.

TYPE OF SCREEN OR PERFORATION MATERIAL: 1 Steel, 2 Brass, 3 Stainless steel, 4 Galvanized steel, 5 Fiberglass, 6 Concrete tile, 7 PVC, 8 RMP (SR), 9 ABS, 10 Asbestos-cement, 11 Other (specify), 12 None used (open hole)

SCREEN OR PERFORATION OPENINGS ARE: 1 Continuous slot, 2 Louvered shutter, 3 Mill slot, 4 Key punched, 5 Gauzed wrapped, 6 Wire wrapped, 7 Torch cut, 8 Saw cut, 9 Drilled holes, 10 Other (specify), 11 None (open hole)

SCREEN-PERFORATED INTERVALS: From 40 ft. to 60 ft. GRAVEL PACK INTERVALS: From 20 ft. to 60 ft.

6) GROUT MATERIAL: 1 Neat cement, 2 Cement grout, 3 Bentonite, 4 Other Grout intervals: From 0 ft. to 20 ft.

What is the nearest source of possible contamination: 1 Septic tank, 2 Sewer lines, 3 Watertight sewer lines, 4 Lateral lines, 5 Cess pool, 6 Seepage pit, 7 Pit privy, 8 Sewage lagoon, 9 Feedyard, 10 Livestock pens, 11 Fuel storage, 12 Fertilizer storage, 13 Insecticide storage, 14 Abandoned water well, 15 Oil well/Gas well, 16 Other (specify below)

Direction from well? North East How many feet? 2100

Table with columns: FROM, TO, LITHOLOGIC LOG, FROM, TO, PLUGGING INTERVALS. Rows show depth intervals from 0 to 60 feet and lithologic descriptions: Top soil & clay, Sand & Gravel, Sand & Gravel, some rocks, Sand & Gravel.

7) CONTRACTOR'S OR LANDOWNER'S CERTIFICATION: This water well was (1) constructed, (2) reconstructed, or (3) plugged under my jurisdiction and was completed on (mo/day/year) 11/6/91 and this record is true to the best of my knowledge and belief. Kansas Water Well Contractor's License No. 480 This Water Well Record was completed on (mo/day/year) 11/21/97 under the business name of Williams Drilling Co., Inc. by (signature) For Williams