


1 LOCATION OF WATER-WELL: Fraction SW 1/4 NW 1/4 NW 1/4 Section Number 9 Township Number T 4 S Range Number R 4 E/W  
 County: REPUBLIC

Distance and direction from nearest town or city street address of well if located within city?  
4.5 miles From Scandia

2 WATER WELL OWNER: Lloyd Blosser (Lloyd) Board of Agriculture, Division of Water Resources  
 RR#, St. Address, Box #: Scandia, KS 66966 Application Number:  
 City, State, ZIP Code:

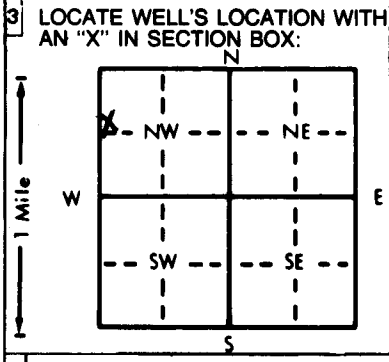

4 DEPTH OF COMPLETED WELL: 52 ft. ELEVATION: 1410'  
 Depth(s) Groundwater Encountered 1. 8 ft. 2. . ft. 3. . ft.  
 WELL'S STATIC WATER LEVEL 8 ft. below land surface measured on mo/day/yr 7/13/87  
 Pump test data: Well water was . ft. after . hours pumping . gpm  
 Est. Yield 1200 gpm: Well water was . ft. after . hours pumping . gpm  
 Bore Hole Diameter 3.2 in. to 52 ft., and . in. to . ft.  
 WELL WATER TO BE USED AS: 5 Public water supply 8 Air conditioning 11 Injection well  
 1 Domestic 3 Feedlot 6 Oil field water supply 9 Dewatering 12 Other (Specify below)  
 ② Irrigation 4 Industrial 7 Lawn and garden only 10 Observation well  
 Was a chemical/bacteriological sample submitted to Department? Yes No; If yes, mo/day/yr sample was submitted  
 Water Well Disinfected? Yes No

5 TYPE OF BLANK CASING USED: 5 Wrought iron 8 Concrete tile CASING JOINTS: Glued . . . Clamped X  
 1 Steel 3 RMP (SR) ⑥ Asbestos-Cement 9 Other (specify below) Welded . . .  
 2 PVC 4 ABS 7 Fiberglass . . . Threaded . . .  
 Blank casing diameter 1.6" in. to . ft., Dia . in. to . ft., Dia . in. to . ft.  
 Casing height above land surface 16 in., weight . lbs./ft. Wall thickness or gauge No. 74 inch  
 TYPE OF SCREEN OR PERFORATION MATERIAL: 7 PVC ⑩ Asbestos-cement  
 1 Steel 3 Stainless steel 5 Fiberglass 8 RMP (SR) 11 Other (specify) . . .  
 2 Brass 4 Galvanized steel 6 Concrete tile 9 ABS 12 None used (open hole)  
 SCREEN OR PERFORATION OPENINGS ARE: 5 Gauzed wrapped ⑨ Saw cut 11 None (open hole)  
 1 Continuous slot 3 Mill slot 6 Wire wrapped 9 Drilled holes  
 2 Louvered shutter 4 Key punched 7 Torch cut 10 Other (specify) . . .  
 SCREEN-PERFORATED INTERVALS: From 1.3 ft. to 52 ft., From . ft. to . ft.  
 From . ft. to . ft., From . ft. to . ft.  
 GRAVEL PACK INTERVALS: From 52 ft. to 10 ft., From . ft. to . ft.  
 From . ft. to . ft., From . ft. to . ft.

6 GROUT MATERIAL: 1 Neat cement ② Cement grout 3 Bentonite 4 Other . . .  
 Grout Intervals: From 10 ft. to 0 ft., From . ft. to . ft., From . ft. to . ft.  
 What is the nearest source of possible contamination: 10 Livestock pens 14 Abandoned water well  
 1 Septic tank 4 Lateral lines 7 Pit privy 11 Fuel storage 15 Oil well/Gas well  
 2 Sewer lines 5 Cess pool 8 Sewage lagoon 12 Fertilizer storage 16 Other (specify below)  
 3 Watertight sewer lines 6 Seepage pit 9 Feedyard 13 Insecticide storage . . .

Direction from well? How many feet?

FROM	TO	LITHOLOGIC LOG	FROM	TO	LITHOLOGIC LOG
0	9	sandy clay - fine sand layer.			
9	47	Coarse Blue Sand.			
47	52	Clay & Rock			

7 CONTRACTOR'S OR LANDOWNER'S CERTIFICATION: This water well was (1) constructed, (2) reconstructed, or (3) plugged under my jurisdiction and was completed on (mo/day/year) 7-15-87 and this record is true to the best of my knowledge and belief. Kansas Water Well Contractor's License No. 272 This Water Well Record was completed on (mo/day/yr) 8-12-87 under the business name of SHUCK DRILLING CO. by (signature) Jerry L. Shuck

INSTRUCTIONS: Use typewriter or ball point pen. PLEASE PRESS FIRMLY and PRINT clearly. Please fill in blanks, underline or circle the correct answers. Send top three copies to Kansas Department of Health and Environment, Bureau of Water Protection, Topeka, Kansas 66620-7320, Telephone: 913-862-9360. Send one to WATER WELL OWNER and retain one for your records.