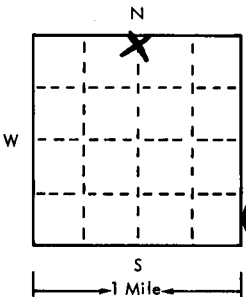
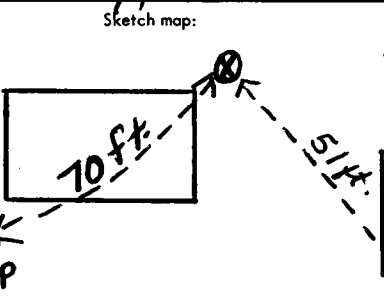


USE TYPEWRITER OR BALL  
POINT PEN-PRESS FIRMLY,  
PRINT CLEARLY.

**TRI-VALLEY IRRIGATION**  
Water Well Drilling  
Valley Self Propelled Sales and Service  
Box 26, Norway, Kansas 66961  
WATER WELL RECORD  
KSA 82a-1201-1215

**4 4 W 21 N 1/4 NE**  
T R EW sec 1/4 1/4 1/4 No.

Kansas State Dept. Of Health  
(Water Well Contractors)  
Forbes-Bldg. 740  
Topeka, Kansas 66620

1 Location of well:		County <b>Republic</b>	Township name <b>Norway</b>	Fraction <b>NW/NE</b>	Section number <b>21</b>	Town number <b>4S</b>	Range number <b>4W</b>
Distance and direction from nearest town or city: Street address of well location if in city: <b>Norway, KS</b>				3 Owner of well: Address: <b>Mrs. W.F. Whitebread 133 W 19th Concordia, KS 66901</b>			
Locate with "X" in section below: 				Sketch map: 			
2				Type and color of material	From	To	
				<b>top Soil</b>	<b>0</b>	<b>2</b>	
				<b>Sand dry yellowish tan</b>	<b>2</b>	<b>16</b>	
				<b>Sand water yellowish tan</b>	<b>16</b>	<b>22</b>	
				<b>Gravel Small</b>	<b>22</b>	<b>28</b>	
				<b>Calcinized layer</b>	<b>28</b>	<b>28.4</b>	
				<b>Green gravel &amp; green sand</b>	<b>28.4</b>	<b>60</b>	
				<b>Drilled to 60ft. cased at 50'. Sealed at 30ft. to 27ft. grouted 14ft. to 4ft.</b>			
				<b>Nearest Pollution 51 ft. Sewer Line Lateral.</b>			
				(use a second sheet if needed)			
16 Remarks: elevation <b>1400</b>				17 Water well contractor's certification: This well was drilled under my jurisdiction and this report is true to the best of my knowledge and belief. <b>Tri-Valley Irrigation</b> Business name Address <b>Box 26 Norway, KS</b> Signed <b>J.R.</b> Date <b>10-21-75</b> Authorized representative			

4  
4 W  
21  
NW NE