


1 LOCATION OF WATER WELL: County: Republic Fraction NW 1/4 NE 1/4 SW 1/4 Section Number 21 Township Number T 4 S Range Number R 4 R/W

Distance and direction from nearest town or city street address of well if located within city? 1/2 mile south of Norway Ks.

2 WATER WELL OWNER: Lloyd Blosser RR#, St. Address, Box #: 1004 18th St. City, State, ZIP Code: Bellville Ks. 66935 Board of Agriculture, Division of Water Resources Application Number:

3 LOCATE WELL'S LOCATION WITH AN 'X' IN SECTION BOX: DEPTH OF COMPLETED WELL: 67 ft. ELEVATION:

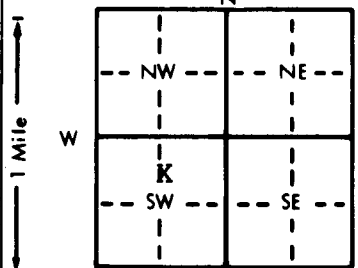

Depth(s) Groundwater Encountered: 26 ft. WELL'S STATIC WATER LEVEL: 26 ft. below land surface measured on mo/day/yr Pump test data: Well water was 33 ft. after 1 hours pumping 800 gpm Est. Yield 1800 gpm: Well water was 40 ft. after 1 hours pumping 1500 gpm Bore Hole Diameter: 26 in. to 67 ft., and in. to in. to in. to in. to WELL WATER TO BE USED AS: 2 Irrigation 4 Industrial 7 Lawn and garden only 10 Monitoring well Was a chemical/bacteriological sample submitted to Department? Yes No X; If yes, mo/day/yr sample was submitted Water Well Disinfected? Yes No

5 TYPE OF BLANK CASING USED: 1 Steel 3 RMP (SR) 5 Wrought iron 8 Concrete tile CASING JOINTS: Glued Clamped 2 PVC 4 ABS 6 Asbestos-Cement 9 Other (specify below) Welded Threaded

Blank casing diameter: 16 in. to 28 ft., Dia. in. to in. to ft., Dia. in. to in. to in. to in. to Casing height above land surface: in., weight in. lbs./ft. Wall thickness or gauge No.

TYPE OF SCREEN OR PERFORATION MATERIAL: 1 Steel 3 Stainless steel 5 Fiberglass 8 RMP (SR) 10 Asbestos-cement 2 Brass 4 Galvanized steel 6 Concrete tile 9 ABS 11 Other (specify) 12 None used (open hole)

SCREEN OR PERFORATION OPENINGS ARE: 1 Continuous slot 3 Mill slot 5 Gauzed wrapped 8 Saw cut 11 None (open hole) 2 Louvered shutter 4 Key punched 6 Wire wrapped 9 Drilled holes 7 Torch cut 10 Other (specify)

SCREEN-PERFORATED INTERVALS: From 40 ft. to 67 ft., From ft. to ft. to ft. to ft. to ft. to ft. to GRAVEL PACK INTERVALS: From ft. to ft. to ft. to ft. to ft. to ft. to

6 GROUT MATERIAL: 1 Neat cement 2 Cement grout 3 Bentonite 4 Other Grout Intervals: From 0 ft. to 20 ft., From ft. to ft. to ft. to ft. to ft. to ft. to

What is the nearest source of possible contamination: 1 Septic tank 4 Lateral lines 7 Pit privy 10 Livestock pens 14 Abandoned water well 2 Sewer lines 5 Cess pool 8 Sewage lagoon 11 Fuel storage 15 Oil well/Gas well 3 Watertight sewer lines 6 Seepage pit 9 Feedyard 12 Fertilizer storage 16 Other (specify below) 13 Insecticide storage

Direction from well? north How many feet? 1/2 mile

Table with columns: FROM, TO, LITHOLOGIC LOG, FROM, TO, PLUGGING INTERVALS. Contains entries for topsoil, clay, fine sand, sand & gravel med. to coarse, sand & gravel fine with blue clay layer, sand & gravel blue med. to coarse.

7 CONTRACTOR'S OR LANDOWNER'S CERTIFICATION: This water well was (1) constructed, (2) reconstructed, or (3) plugged under my jurisdiction and was completed on (mo/day/year) 7-18-90 and this record is true to the best of my knowledge and belief. Kansas Water Well Contractor's License No. 272 This Water Well Record was completed on (mo/day/yr) 7-18-90 under the business name of Shuck Drilling Co. by (signature) Jerry S. Shuck

INSTRUCTIONS: Use typewriter or ball point pen. PLEASE PRESS FIRMLY and PRINT clearly. Please fill in blanks, underline or circle the correct answers. Send top three copies to Kansas Department of Health and Environment, Bureau of Water Protection, Topeka, Kansas 66620-7320. Telephone: 913-296-5514. Send one to WATER WELL OWNER and retain one for your records.