


1 LOCATION OF WATER WELL: Fraction NE 1/4 NW 1/4 NW 1/4 Section Number 28 Township Number T 4 S Range Number R 4W EW
 County: Republic

Distance and direction from nearest town or city street address of well if located within city?
 from Norway - 1/2 mile west, 1 mile south

2 WATER WELL OWNER: Glenn Stensaas
 RR#, St. Address, Box #: Route 2 Board of Agriculture, Division of Water Resources
 City, State, ZIP Code: Concordia, Ks. 66901 Application Number: 36,990

3 LOCATE WELL'S LOCATION WITH AN "X" IN SECTION BOX:

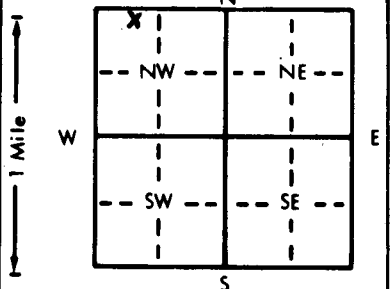

4 DEPTH OF COMPLETED WELL: 72' ft. ELEVATION: 1404'
 Depth(s) Groundwater Encountered 1. 30' ft. 2. ft. 3. ft.
 WELL'S STATIC WATER LEVEL 18' ft. below land surface measured on mo/day/yr 5-24-84
 Pump test data: Well water was 28' ft. after 3/4 hours pumping 1,000 gpm
 Est. Yield 1,000+ gpm: Well water was ft. after hours pumping gpm
 Bore Hole Diameter 30" in. to 72' ft., and in. to ft.
 WELL WATER TO BE USED AS:
 5 Public water supply 8 Air conditioning 11 Injection well
 1 Domestic 3 Feedlot 6 Oil field water supply 9 Dewatering 12 Other (Specify below)
 X 2 Irrigation 4 Industrial 7 Lawn and garden only 10 Observation well
 Was a chemical/bacteriological sample submitted to Department? Yes No X; If yes, mo/day/yr sample was submitted Water Well Disinfected? Yes X No

5 TYPE OF BLANK CASING USED:
 1 Steel 3 RMP (SR) X 6 Asbestos-Cement 8 Concrete tile CASING JOINTS: Glued Clamped X
 2 PVC 4 ABS 7 Fiberglass 9 Other (specify below) Welded
 Blank casing diameter 16" in. to 46' ft., Dia. in. to ft., Dia. in. to ft.
 Casing height above land surface 12" in., weight 34# lbs./ft. Wall thickness or gauge No. 3/4"
 TYPE OF SCREEN OR PERFORATION MATERIAL:
 1 Steel 3 Stainless steel 5 Fiberglass 7 PVC X 10 Asbestos-cement
 2 Brass 4 Galvanized steel 6 Concrete tile 8 RMP (SR) 11 Other (specify)
 9 ABS 12 None used (open hole)
 SCREEN OR PERFORATION OPENINGS ARE:
 1 Continuous slot 3 Mill slot 5 Gauzed wrapped X 8 Saw cut 11 None (open hole)
 2 Louvered shutter 4 Key punched 6 Wire wrapped 9 Drilled holes
 7 Torch cut 10 Other (specify)
 SCREEN-PERFORATED INTERVALS: From 46' ft. to 72' ft., From ft. to ft. to ft. to ft.
 GRAVEL PACK INTERVALS: From 10' ft. to 72' ft., From ft. to ft. to ft. to ft.

6 GROUT MATERIAL: 1 Neat cement X 2 Cement grout 3 Bentonite 4 Other
 Grout Intervals: From 0 ft. to 10 ft., From ft. to ft. to ft. to ft. to ft. to ft.
 What is the nearest source of possible contamination: NONE
 1 Septic tank 4 Lateral lines 7 Pit privy 10 Livestock pens 14 Abandoned water well
 2 Sewer lines 5 Cess pool 8 Sewage lagoon 11 Fuel storage 15 Oil well/Gas well
 3 Watertight sewer lines 6 Seepage pit 9 Feedyard 12 Fertilizer storage 16 Other (specify below)
 13 Insecticide storage

Direction from well? How many feet?

FROM	TO	LITHOLOGIC LOG	FROM	TO	LITHOLOGIC LOG
0	5	Sand			
5	17	Clay			
17	30	Sand			
30	33	Sand & Gravel			
33	38	Gravel			
38	40	Good Gravel			
40	43	Sand			
43	53	Gravel - Good			
53	72	Gravel - Fair			
72		Sand & Gravel			

7 CONTRACTOR'S OR LANDOWNER'S CERTIFICATION: This water well was (1) constructed, (2) reconstructed, or (3) plugged under my jurisdiction and was completed on (mo/day/year) May 11, 1984 and this record is true to the best of my knowledge and belief. Kansas Water Well Contractor's License No. 361 This Water Well Record was completed on (mo/day/yr) May 25, 1984 under the business name of Cox-Beswick Irrigation Service, Inc. by (signature) Francis Cox

INSTRUCTIONS: Use typewriter or ball point pen, PLEASE PRESS FIRMLY and PRINT clearly. Please fill in blanks, underline or circle the correct answers, Send top three copies to Kansas Department of Health and Environment, Division of Environment, Environmental Geology Section, Topeka, KS 66620. Send one to WATER WELL OWNER and retain one for your records.