


WATER WELL RECORD Form WWC-5 KSA 82a-1212

1 LOCATION OF WATER WELL: County: Republic Fraction: NW 1/4 SE 1/4 NE 1/4 Section Number: 29 Township Number: T4 S Range Number: R 14 E W Distance and direction from nearest town or city street address of well if located within city? Lots 1, 2 & 6 of River Record "A" 207

2 WATER WELL OWNER: RR#, St. Address, Box #: City, State, ZIP Code: Board of Agriculture, Division of Water Resources Application Number:

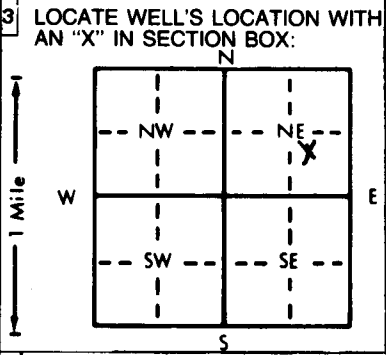

3 LOCATE WELL'S LOCATION WITH AN "X" IN SECTION BOX: 4 DEPTH OF COMPLETED WELL: 59 ft. ELEVATION: WELL'S STATIC WATER LEVEL: 6 ft. below land surface measured on mo/day/yr Pump test data: Well water was ... Est. Yield ... Bore Hole Diameter ... WELL WATER TO BE USED AS: 1 Domestic, 2 Irrigation, 3 Feedlot, 4 Industrial, 5 Public water supply, 6 Oil field water supply, 7 Lawn and garden only, 8 Air conditioning, 9 Dewatering, 10 Monitoring well, 11 Injection well, 12 Other (Specify below) Was a chemical/bacteriological sample submitted to Department? Yes No X; If yes, mo/day/yr sample was submitted Water Well Disinfected? Yes X No

5 TYPE OF BLANK CASING USED: 1 Steel, 2 PVC, 3 RMP (SR), 4 ABS, 5 Wrought iron, 6 Asbestos-Cement, 7 Fiberglass, 8 Concrete tile, 9 Other (specify below), CASING JOINTS: Glued, Clamped, Welded, Threaded. Blank casing diameter: 5 in. to ... Dia: ... in. to ... ft., Dia: ... in. to ... ft. Casing height above land surface: 3 Below in., weight ... lbs./ft. Wall thickness or gauge No. TYPE OF SCREEN OR PERFORATION MATERIAL: 1 Steel, 2 Brass, 3 Stainless steel, 4 Galvanized steel, 5 Fiberglass, 6 Concrete tile, 7 PVC, 8 RMP (SR), 9 ABS, 10 Asbestos-cement, 11 Other (specify) NA, 12 None used (open hole) SCREEN OR PERFORATION OPENINGS ARE: 1 Continuous slot, 2 Louvered shutter, 3 Mill slot, 4 Key punched, 5 Gauzed wrapped, 6 Wire wrapped, 7 Torch cut, 8 Saw cut, 9 Drilled holes, 11 None (open hole) SCREEN-PERFORATED INTERVALS: From ... ft. to ... ft., From ... ft. to ... ft., From ... ft. to ... ft. GRAVEL PACK INTERVALS: From ... ft. to ... ft., From ... ft. to ... ft., From ... ft. to ... ft.

6 GROUT MATERIAL: 1 Neat cement, 2 Cement grout, 3 Bentonite, 4 Other. Grout Intervals: From ... ft. to ... ft., From ... ft. to ... ft., From ... ft. to ... ft. What is the nearest source of possible contamination: 1 Septic tank, 2 Sewer lines, 3 Watertight sewer lines, 4 Lateral lines, 5 Cess pool, 6 Seepage pit, 7 Pit privy, 8 Sewage lagoon, 9 Feedyard, 10 Livestock pens, 11 Fuel storage, 12 Fertilizer storage, 13 Insecticide storage, 14 Abandoned water well, 15 Oil well/Gas well, 16 Other (specify below) NONE Direction from well? How many feet?

Direction from well? How many feet? LITHOLOGIC LOG FROM TO FROM TO PLUGGING INTERVALS

*filled with chert designated sand & gravel to water level then effect of concrete then covered over with good dirt*

7 CONTRACTOR'S OR LANDOWNER'S CERTIFICATION: This water well was (1) constructed, (2) reconstructed, or (3) plugged under my jurisdiction and was completed on (mo/day/year) 4-5-90 and this record is true to the best of my knowledge and belief. Kansas Water Well Contractor's License No. This Water Well Record was completed on (mo/day/yr) under the business name of Bonnie Brown Arms by (signature) Stanley M. McMillan

INSTRUCTIONS: Use typewriter or ball point pen. PLEASE PRESS FIRMLY and PRINT clearly. Please fill in blanks, underline or circle the correct answers. Send top three copies to Kansas Department of Health and Environment, Bureau of Water, Topeka, Kansas 66620-7320. Telephone: 913-296-5545. Send one to WATER WELL OWNER and retain one for your records.