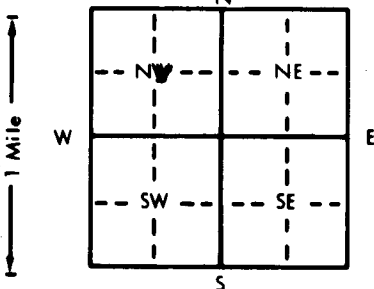


1 LOCATION OF WATER WELL: County: REPUBLIC Fraction SW 1/4 NE 1/4 NW 1/4 Section Number 33 Township Number T 4 S Range Number R 4W E/W

Distance and direction from nearest town or city street address of well if located within city?
 FROM Norway - 2 1/2 miles South, 1/2 mile West

2 WATER WELL OWNER: Bonnie Brow Partnership
 RR#, St. Address, Box # : Route 1
 City, State, ZIP Code : Jamestown, Kansas 66948
 Board of Agriculture, Division of Water Resources
 Application Number: 36,598

3 LOCATE WELL'S LOCATION WITH AN "X" IN SECTION BOX:

 4 DEPTH OF COMPLETED WELL: 61' ft. ELEVATION: 1400'
 Depth(s) Groundwater Encountered 1 6' ft. 2. ft. 3. ft.
 WELL'S STATIC WATER LEVEL 6' ft. below land surface measured on mo/day/yr 7-18-83
 Pump test data: Well water was 61' ft. after 3/4 hours pumping 2,000 gpm
 Est. Yield 2,000 gpm: Well water was 61' ft. after 3/4 hours pumping 2,000 gpm
 Bore Hole Diameter 32" in. to 61' ft., and in. to ft.
 WELL WATER TO BE USED AS:
 5 Public water supply 8 Air conditioning 11 Injection well
 1 Domestic 3 Feedlot 6 Oil field water supply 9 Dewatering 12 Other (Specify below)
 X2 Irrigation 4 Industrial 7 Lawn and garden only 10 Observation well
 Was a chemical/bacteriological sample submitted to Department? Yes.....No. X.....; If yes, mo/day/yr sample was submitted
 Water Well Disinfected? Yes No X

5 TYPE OF BLANK CASING USED:
 1 Steel 3 RMP (SR) 5 Wrought iron 8 Concrete tile CASING JOINTS: Glued.....Clamped X.....
 2 PVC 4 ABS X6 Asbestos-Cement 9 Other (specify below) Welded.....
 7 Fiberglass Threaded.....
 Blank casing diameter 16" in. to 35' ft., Dia 34 in. to ft., Dia in. to ft.
 Casing height above land surface 12 in., weight 34 lbs./ft. Wall thickness or gauge No. 3/4
 TYPE OF SCREEN OR PERFORATION MATERIAL:
 1 Steel 3 Stainless steel 5 Fiberglass 7 PVC X10 Asbestos-cement
 2 Brass 4 Galvanized steel 6 Concrete tile 8 RMP (SR) 11 Other (specify).....
 12 None used (open hole)
 SCREEN OR PERFORATION OPENINGS ARE:
 1 Continuous slot 3 Mill slot 5 Gauzed wrapped X8 Saw cut 11 None (open hole)
 2 Louvered shutter 4 Key punched 6 Wire wrapped 9 Drilled holes
 7 Torch cut 10 Other (specify).....
 SCREEN-PERFORATED INTERVALS: From 35 ft. to 61 ft., From ft. to ft. to ft.
 GRAVEL PACK INTERVALS: From 10 ft. to 61 ft., From ft. to ft. to ft.

6 GROUT MATERIAL: 1 Neat cement X2 Cement grout 3 Bentonite 4 Other.....
 Grout Intervals: From 0 ft. to 10 ft., From ft. to ft. to ft. to ft. to ft.
 What is the nearest source of possible contamination: NONE
 1 Septic tank 4 Lateral lines 7 Pit privy 10 Livestock pens 14 Abandoned water well
 2 Sewer lines 5 Cess pool 8 Sewage lagoon 11 Fuel storage 15 Oil well/Gas well
 3 Watertight sewer lines 6 Seepage pit 9 Feedyard 12 Fertilizer storage 16 Other (specify below)
 13 Insecticide storage
 Direction from well? How many feet?

FROM	TO	LITHOLOGIC LOG	FROM	TO	LITHOLOGIC LOG
0	6	Top Soil & Sand			
6	61	Gravel			

7 CONTRACTOR'S OR LANDOWNER'S CERTIFICATION: This water well was (1) constructed, (2) reconstructed, or (3) plugged under my jurisdiction and was completed on (mo/day/year) July 18, 1983 and this record is true to the best of my knowledge and belief. Kansas Water Well Contractor's License No. 361 This Water Well Record was completed on (mo/day/yr) July 18, 1983 under the business name of Cox-Beswick Irrigation Service, Inc. by (signature) *Jessie Cox*

INSTRUCTIONS: Use typewriter or ball point pen, PLEASE PRESS FIRMLY and PRINT clearly. Please fill in blanks, underline or circle the correct answers, Send top three copies to Kansas Department of Health and Environment, Division of Environment, Environmental Geology Section, Topeka, KS 66620. Send one to WATER WELL OWNER and retain one for your records.

OFFICE USE ONLY
T
4
R
4
SEC
33
SW 1/4 NE 1/4 NW 1/4