


1 LOCATION OF WATER WELL: County: **REPUBLIC** Fraction: **W 1/2 1/4 W 1/2 1/4 SW 1/4** Section Number: **34** Township Number: **T 4 S** Range Number: **R 4 W E/W**

Distance and direction from nearest town or city street address of well if located within city?
1/2 Mile East, 3 Miles South of Norway

2 WATER WELL OWNER: **David Brewer**
 RR#, St. Address, Box #: **Route 2**
 City, State, ZIP Code: **Concordia, Ks. 66901**
 Board of Agriculture, Division of Water Resources
 Application Number: **35,487**

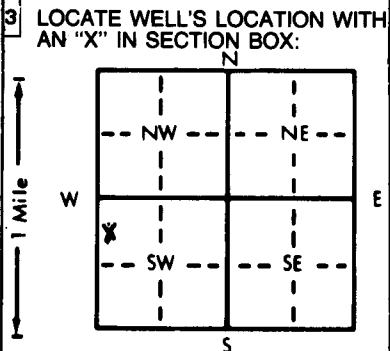

4 DEPTH OF COMPLETED WELL: **68'** ft. ELEVATION: **139.0'**
 Depth(s) Groundwater Encountered: **9', 18'** ft. 2. ft. 3. ft.
 WELL'S STATIC WATER LEVEL: **5-11-1982** ft. below land surface measured on mo/day/yr
 Pump test data: Well water was **28** ft. after **1 1/2** hours pumping **1200+** gpm
 Est. Yield: **1200+** gpm: Well water was **28** ft. after **1 1/2** hours pumping **1200+** gpm
 Bore Hole Diameter: **32"** in. to **34"** in. to **34"** in. to
 WELL WATER TO BE USED AS:
 1 Domestic 3 Feedlot 6 Oil field water supply 9 Dewatering 12 Other (Specify below)
 2 Irrigation 4 Industrial 7 Lawn and garden only 10 Observation well
 Was a chemical/bacteriological sample submitted to Department? Yes No ; If yes, mo/day/yr sample was submitted
 Water Well Disinfected? Yes No

5 TYPE OF BLANK CASING USED:
 1 Steel 3 RMP (SR) 6 Asbestos-Cement 8 Concrete tile CASING JOINTS: Glued Clamped
 2 PVC 4 ABS 7 Fiberglass 9 Other (specify below) Welded
 Blank casing diameter: **16"** in. to **42"** in. Dia. **34"** in. to **34"** in. Dia. **3/4** in. to **3/4** in. Dia.
 Casing height above land surface: **12"** in., weight **34#** lbs./ft. Wall thickness or gauge No. **3/4**
 TYPE OF SCREEN OR PERFORATION MATERIAL:
 1 Steel 3 Stainless steel 5 Fiberglass 7 PVC 10 Asbestos-cement
 2 Brass 4 Galvanized steel 6 Concrete tile 8 RMP (SR) 11 Other (specify)
 9 ABS 12 None used (open hole)
 SCREEN OR PERFORATION OPENINGS ARE:
 1 Continuous slot 3 Mill slot 5 Gauzed wrapped 8 Saw cut 11 None (open hole)
 2 Louvered shutter 4 Key punched 6 Wire wrapped 9 Drilled holes
 7 Torch cut 10 Other (specify)
 SCREEN-PERFORATED INTERVALS: From **42'** ft. to **55'** ft., From **55'** ft. to **68'** ft., From **68'** ft. to **68'** ft.
Double Perf. - From **55'** ft. to **68'** ft., From **68'** ft. to **68'** ft.
 GRAVEL PACK INTERVALS: From **10'** ft. to **68'** ft., From **68'** ft. to **68'** ft.

6 GROUT MATERIAL: 1 Neat cement 2 Cement grout 3 Bentonite 4 Other
 Grout Intervals: From **0** ft. to **10** ft., From **10** ft. to **10** ft., From **10** ft. to **10** ft.
 What is the nearest source of possible contamination: **NONE**
 1 Septic tank 4 Lateral lines 7 Pit privy 10 Livestock pens 14 Abandoned water well
 2 Sewer lines 5 Cess pool 8 Sewage lagoon 11 Fuel storage 15 Oil well/Gas well
 3 Watertight sewer lines 6 Seepage pit 9 Feedyard 12 Fertilizer storage 16 Other (specify below)
 13 Insecticide storage

Direction from well? How many feet?

FROM	TO	LITHOLOGIC LOG	FROM	TO	LITHOLOGIC LOG
0	3	Top Soil			
3	9	Clay			
9	11	Clay & Sand			
11	13	Clay			
13	14	Clay & Sand			
14	18	Course Sand			
18	20	Gravel			
20	34	Course Gravel			
34	38	Small Gravel			
38	48	Course Gravel			
48	50	Small Gravel			
50	68	Course Gravel - Stop			

7 CONTRACTOR'S OR LANDOWNER'S CERTIFICATION: This water well was (1) constructed, (2) reconstructed, or (3) plugged under my jurisdiction and was completed on (mo/day/year) **May 3, 1982** and this record is true to the best of my knowledge and belief. Kansas Water Well Contractor's License No. **361** This Water Well Record was completed on (mo/day/yr) **JULY 21, 1982** under the business name of **Cox-Beswick Irrigation Service, Inc.** by (signature) **Francis G.**

INSTRUCTIONS: Use typewriter or ball point pen, PLEASE PRESS FIRMLY and PRINT clearly. Please fill in blanks, underline or circle the correct answers. Send top three copies to Kansas Department of Health and Environment, Division of Environment, Environmental Geology Section, Topeka, KS 66620. Send one to WATER WELL OWNER and retain one for your records.