

County: Cheyenne Fraction: N2, S2, S2, NW Sec. 15 T. 4 S R. 40 W

CORRECTION(S) to WATER WELL COMPLETION RECORD Form WWC-5 (to rectify lacking or incorrect information)

Owner: Harkins Farms LLP

If location corrected, was listed as:

Location changed to:

Section-Township-Range: _____

Fraction (1/4 calls): E, SW, NW

N2, S2, S2, NW

Other changes: Initial statements: Horizontal datum not reported. Well location not provided - Not at well owner address. Casing height 12 inches above land surface. Well use reported as domestic.

Changed to: HD WGS84. Well 4.5 miles S of St. Francis on Co Rd 14, and 1/4 mile E.

Well use Other - Livestock.

Comments: Well enclosed in cement slab 12-inches thick. Plugged to top of casing.

Verification method: Information confirmed by contractor (Ross Mfg). QFs confirmed with STR Finder.

Lat/Long coordinates with Google Earth confirm contractor's lat/long coordinates.

Initials: PKC Date: 3/3/2021

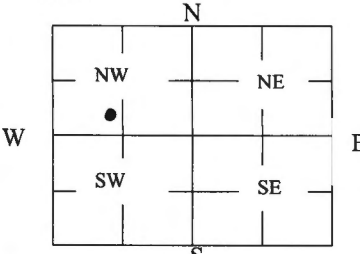
Submitted by: Kansas Geological Survey, Data Resources Library, 1930 Constant Ave., Lawrence, KS 66047-3724

Kansas Dept. of Health & Environment, Bureau of Water, 1000 SW Jackson, Suite 420, Topeka, KS 66612-1367

1 LOCATION OF WATER WELL: County: <u>Cheyenne</u>	Fraction <u>1/4 E 1/4 SW 1/4 NW 1/4</u>	Section Number <u>15</u>	Township Number <u>T 4 S</u>	Range Number <u>40</u> <input type="checkbox"/> E <input checked="" type="checkbox"/> W
-------------------------------------------------------------	-----------------------------------------	--------------------------	------------------------------	-----------------------------------------------------------------------------------------

Street/Rural Address of Well Location; if unknown, distance & direction from nearest town or intersection: If at owner's address, check here <input type="checkbox"/>	Global Positioning Systems (GPS) information: Latitude: <u>39.707131</u> (in decimal degrees) Longitude: <u>-101.801435</u> (in decimal degrees) Elevation: <u>3302</u> Horizontal Datum: <input type="checkbox"/> WGS84, <input type="checkbox"/> NAD83, <input type="checkbox"/> NAD27 Collection Method: <input type="checkbox"/> GPS unit (Make/Model: _____) <input type="checkbox"/> Digital Map/Photo, <input type="checkbox"/> Topographic Map, <input type="checkbox"/> Land Survey Est. Accuracy: <input type="checkbox"/> < 3 m, <input type="checkbox"/> 3-5 m, <input type="checkbox"/> 5-15 m, <input type="checkbox"/> > 15 m
---	---

2 WATER WELL OWNER: <u>Harkins Farm LLP</u> RR#, St. Address, Box #: <u>1372 N 19th St.</u> City, State ZIP Code: <u>Laramie, WY 82072</u>	
---	--

3 MARK WELL'S LOCATION WITH AN "X" IN SECTION BOX: 	4 DEPTH OF WELL <u>175</u> ft. WELL'S STATIC WATER LEVEL <u>156</u> ft. WELL WAS USED AS: <input checked="" type="checkbox"/> Domestic <input type="checkbox"/> Public Water Supply <input type="checkbox"/> Dewatering <input type="checkbox"/> Irrigation <input type="checkbox"/> Oil Field Water Supply <input type="checkbox"/> Monitoring <input type="checkbox"/> Feedlot <input type="checkbox"/> Domestic (Lawn & Garden) <input type="checkbox"/> Injection Well <input type="checkbox"/> Industrial <input type="checkbox"/> Air Conditioning <input type="checkbox"/> Other _____ Was a chemical/bacteriological sample submitted to Department? Yes <input type="checkbox"/> No <input checked="" type="checkbox"/>
---	---

5 TYPE OF BLANK CASING USED:

Steel RMP (SR) Wrought Fiberglass Other (Specify below)
 PVC ABS Asbestos-Cement Concrete Tile

Blank casing diameter 5 in. Was casing pulled? Yes No If yes, how much _____
 Casing height above or below land surface 12 in.

6 GROUT PLUG MATERIAL: Neat cement Cement grout Bentonite Other _____

Grout Plug Intervals: From 150 ft. to 140 ft., From 15 ft. to 6 ft., From 6 ft. to 0 ft.

What is the nearest source of possible contamination:

<input type="checkbox"/> Septic tank	<input type="checkbox"/> Seepage pit	<input type="checkbox"/> Fuel storage	<input type="checkbox"/> Other (specify below)
<input type="checkbox"/> Sewer lines	<input type="checkbox"/> Pit privy	<input type="checkbox"/> Fertilizer storage	
<input type="checkbox"/> Watertight sewer lines	<input type="checkbox"/> Sewage lagoon	<input type="checkbox"/> Insecticide storage	
<input type="checkbox"/> Lateral lines	<input type="checkbox"/> Feedyard	<input type="checkbox"/> Abandoned water well	Direction from well? _____
<input type="checkbox"/> Cess pool	<input type="checkbox"/> Livestock pens	<input type="checkbox"/> Oil well/Gas well	How many feet? _____

FROM	TO	PLUGGING MATERIALS	FROM	TO	PLUGGING MATERIALS
		<u>Clorox</u>			
<u>175</u>	<u>150</u>	<u>clean sand</u>			
<u>150</u>	<u>140</u>	<u>Bentonite</u>			
<u>140</u>	<u>15</u>	<u>clean sand</u>			
<u>15</u>	<u>6</u>	<u>Bentonite</u>			
<u>6</u>	<u>0</u>	<u>Cement</u>			

7 CONTRACTOR'S OR LANDOWNER'S CERTIFICATION: This water well was plugged under my jurisdiction and was completed on (mo/day/year) 2/9/2021 and this record is true to the best of my knowledge and belief. Kansas Water Well Contractor's License No. _____ This Water Well Record was completed on (mo/day/year) _____ under the business name of Ross mfg by (signature) [Signature]