

USE TYPEWRITER OR BALL POINT PEN-PRESS FIRMLY, PRINT CLEARLY.


WATER WELL RECORD  
KSA 82a-1201-1215

Kansas Department of Health and Environment-Division of Environment (Water well Contractors) Topeka, Kansas 66620

AAA

1. Location of well: County Cheyenne Fraction NE 1/4 NE 1/4 NE 1/4 Section number 2 Township number T 4 S R 40 E/W Range number 40

2. Distance and direction from nearest town or city: 2605T 3. Owner of well: Glen Hill  
Street address of well location if in city: 2504th of St. Francis R.R. or street:  
City, state, zip code: St. Francis, KS 67756

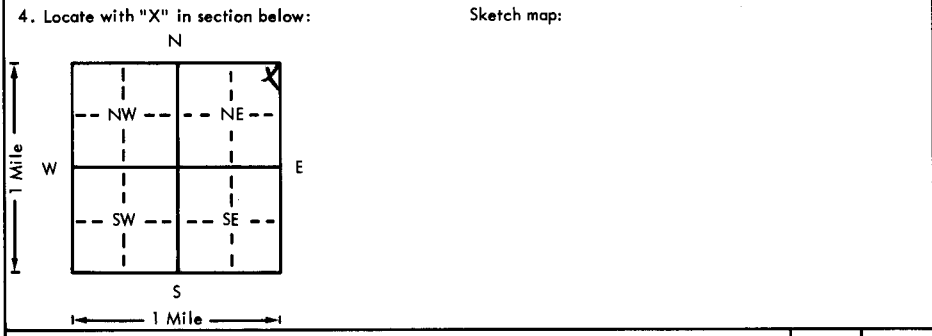

6. Bore hole dia. 8 in. Completion date 11-15-78  
Well depth 145 ft.  
7.  Cable tool  Rotary  Driven  Dug  
 Hollow rod  Jetted  Bored  Reverse rotary  
8. Use:  Domestic  Public supply  Industry  
 Irrigation  Air conditioning  Stock  
 Lawn  Oil field water  Other  
9. Casing: Material plastic Height: Above or below  
Threaded  Welded 66 Surface 12 in.  
RMP  PVC  Weight  lbs./ft.  
Dia. 5 in. to 135 ft. depth Wall Thickness: inches or  
Dia.  in. to  ft. depth gage No. 250

5. Type and color of material	From	To
<u>Top soil</u>	<u>0</u>	<u>2</u>
<u>Y. Brown clay</u>	<u>2</u>	<u>38</u>
<u>Rock - S&amp;G. clay</u>	<u>38</u>	<u>84</u>
<u>Sand Rock</u>	<u>84</u>	<u>89</u>
<u>S&amp;G</u>	<u>89</u>	<u>94</u>
<u>Rock</u>	<u>94</u>	<u>96</u>
<u>S&amp;G. clay</u>	<u>96</u>	<u>103</u>
<u>Sand Rock</u>	<u>103</u>	<u>109</u>
<u>S&amp;G</u>	<u>109</u>	<u>143</u>
<u>shale</u>	<u>143</u>	<u>145</u>
<u>BROCK 143'</u>		

10. Screen: Manufacturer's name J+L  
Type SLOT Dia. 5  
Slot/gauze 115 Length 10'  
Set between 135 ft. and 145 ft.  
ft. and  ft.  
Gravel pack?  Size range of material V8  
11. Static water level: 86 ft. below land surface Date 12/1/78 mo./day/yr.  
12. Pumping level below land surfaces:  
 ft. after  hrs. pumping  g.p.m.  
 ft. after  hrs. pumping  g.p.m.  
Estimated maximum yield 10 g.p.m.  
13. Water sample submitted:  Yes  No Date 12/1/78 mo./day/yr.  
14. Well head completion: 12 inches above grade  
 Pitless adapter  
15. Well grouted?   
With:  Neat cement  Bentonite  Concrete  
Depth: From 0 ft. to 12 ft.  
16. Nearest source of possible contamination: None Direction East  
Well disinfected upon completion?  Yes  No  
17. Pump: Cylinder Not installed   
Manufacturer's name Midwest  
Model number  HP  Volts  
Length of drop pipe 136 ft. capacity 3 g.p.m.  
Type:  
 Submersible  Turbine  
 Jet  Reciprocating  
 Centrifugal  Other

18. Elevation: 19. Remarks:  
Topography:  
 Hill  
 Slope  
 Upland  
 Valley

20. Water well contractor's certification:  
This well was drilled under my jurisdiction and this report is true to the best of my knowledge and belief.  
**SCHOENROGGE DRILLING CO.** 18413  
Bus. Ph. 332-2664 License No. 60  
Address St. Francis, MO  
Signed [Signature] Date 12/1/78  
Authorized representative

T 4 S R 40 E  
Sec 2  
NE 1/4 NE 1/4