


1 LOCATION OF WATER WELL: County: Cheyenne Fraction: NE 1/4 SE 1/4 NW 1/4 Section Number: 14 Township Number: T 4 S Range Number: R 40 EW

Distance and direction from nearest town or city street address of well if located within city?
1/2 mi S of St. Francis KS

2 WATER WELL OWNER: CITY of ST-FRANCIS
 RR#, St. Address, Box #: Box 317 Board of Agriculture, Division of Water Resources
 City, State, ZIP Code: ST. FRANCIS, KS 67756 Application Number: 29031-00

3 LOCATE WELL'S LOCATION WITH AN "X" IN SECTION BOX:
 4 DEPTH OF COMPLETED WELL: 2.65 ft. ELEVATION: 35.40

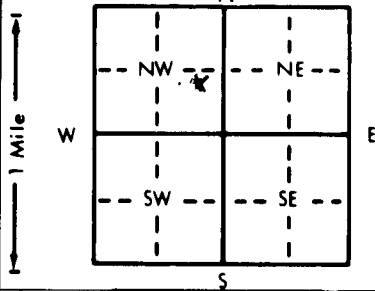

Depth(s) Groundwater Encountered 1. 1.56 ft. 2. _____ ft. 3. _____ ft.
 WELL'S STATIC WATER LEVEL 15.6 ft. below land surface measured on mo/day/yr 6-9-92
 Pump test data: Well water was 1 ft. after _____ hours pumping _____ gpm
 Est. Yield 8.50 gpm: Well water was _____ ft. after _____ hours pumping _____ gpm
 Bore Hole Diameter: 3.0 in. to 2.65 in. to _____ in. to _____ in.
 WELL WATER TO BE USED AS: 5 Public water supply, 8 Air conditioning, 11 Injection well
 1 Domestic, 3 Feedlot, 6 Oil field water supply, 9 Dewatering, 12 Other (Specify below)
 2 Irrigation, 4 Industrial, 7 Lawn and garden only, 10 Monitoring well
 Was a chemical/bacteriological sample submitted to Department? Yes X No _____; If yes, mo/day/yr sample was submitted Water Well Disinfected? Yes X No _____

5 TYPE OF BLANK CASING USED:
 1 Steel, 3 RMP (SR), 5 Wrought iron, 8 Concrete tile, CASING JOINTS: Glued X, Clamped _____
2 PVC, 4 ABS, 6 Asbestos-Cement, 9 Other (specify below), Welded X
 7 Fiberglass, Threaded _____

Blank casing diameter: 1.6 in. to 1.95 ft., Dia. 1.6 in. to 2.65 ft., Dia. _____ in. to _____ ft.
 Casing height above land surface: 36 in., weight _____ lbs./ft. Wall thickness or gauge No. 502.16

TYPE OF SCREEN OR PERFORATION MATERIAL:
 1 ~~Steel~~, 3 Stainless steel, 5 Fiberglass, PVC, 10 Asbestos-cement
 2 Brass, 4 Galvanized steel, 6 Concrete tile, 8 RMP (SR), 11 Other (specify) _____
 9 ABS, 12 None used (open hole)

SCREEN OR PERFORATION OPENINGS ARE:
 1 Continuous slot, Mill slot, 5 Gauzed wrapped, 8 Saw cut, 11 None (open hole)
 2 Louvered shutter, 4 Key punched, Wire wrapped, 9 Drilled holes
 7 Torch cut, 10 Other (specify) _____

SCREEN-PERFORATED INTERVALS: From 1.95 ft. to 2.35 ft., From _____ ft. to _____ ft.
 From 2.31 ft. to 2.61 ft., From 5-5 ft., From _____ ft. to _____ ft.
 GRAVEL PACK INTERVALS: From _____ ft. to _____ ft., From _____ ft. to _____ ft.

6 GROUT MATERIAL: 1 Neat cement, Cement grout, Bentonite, 4 Other _____
 Grout intervals: From 0 ft. to 6 ft., From 6 ft. to 2.8 ft., From _____ ft. to _____ ft.

What is the nearest source of possible contamination:
 1 Septic tank, 4 Lateral lines, 7 Pit privy, Livestock pens, 14 Abandoned water well
 2 Sewer lines, 5 Cess pool, 8 Sewage lagoon, 11 Fuel storage, 15 Oil well/Gas well
 3 Watertight sewer lines, 6 Seepage pit, 9 Feedyard, 12 Fertilizer storage, 16 Other (specify below)
 9 Insecticide storage

Direction from well? NE How many feet? 1360 FT

FROM	TO	LITHOLOGIC LOG	FROM	TO	PLUGGING INTERVALS
0	2	Top soil			
2	12	Clay			
12	16	Rock			
16	28	Sand & Gravel			
28	47	Layers of Rock & clay			
47	65	Sand & Gravel			
65	121	Layers of Rock-Sand-clay			
121	123	Rock			
123	141	clay			
141	161	clay w/ layers of Sand			
161	169	Layers Sand-gravel-clay			
169	189	Sand & Gravel			
189	193	Rock			
193	262	Sand & Gravel / thin layers of clay			
262	265	Shale			

7 CONTRACTOR'S OR LANDOWNER'S CERTIFICATION: This water well was (1) constructed (2) reconstructed, or (3) plugged under my jurisdiction and was completed on (mo/day/year) 9-4-92 and this record is true to the best of my knowledge and belief. Kansas Water Well Contractor's License No. 184 This Water Well Record was completed on (mo/day/yr) 9-25-92 under the business name of Schoen Arge Drilling Inc by (signature) [Signature]