

**WATER WELL RECORD Form WWC-5 KSA 82a-1212**

1 LOCATION OF WATER WELL: County: <u>Cheyenne</u>	Fraction <u>NW 1/4 NW 1/4 NW 1/4</u>	Section Number <u>16</u>	Township Number <u>T 4 S</u>	Range Number <u>R 40 W EW</u>
--	---	-----------------------------	---------------------------------	----------------------------------

Distance and direction from nearest town or city street address of well if located within city?

N/A - LOCATION CONFIRMED BY GMD #4

2 WATER WELL OWNER: <u>Hal L. &amp; Mabel O. Harkins</u> RR#, St. Address, Box # : <u>Box 811</u> City, State, ZIP Code : <u>St. Francis, KS 67756</u>	Board of Agriculture, Division of Water Resources Application Number:
--	--

3 LOCATE WELL'S LOCATION WITH AN "X" IN SECTION BOX:

4 DEPTH OF COMPLETED WELL: 38 ft. ELEVATION: \_\_\_\_\_ ft.

Depth(s) Groundwater Encountered 1. 0 ft. 2. \_\_\_\_\_ ft. 3. \_\_\_\_\_ ft.

WELL'S STATIC WATER LEVEL 0 ft. below land surface measured on mo/day/yr \_\_\_\_\_

Pump test data: Well water was \_\_\_\_\_ ft. after \_\_\_\_\_ hours pumping \_\_\_\_\_ gpm

Est. Yield \_\_\_\_\_ gpm: Well water was \_\_\_\_\_ ft. after \_\_\_\_\_ hours pumping \_\_\_\_\_ gpm


Bore Hole Diameter \_\_\_\_\_ in. to \_\_\_\_\_ ft., and \_\_\_\_\_ in. to \_\_\_\_\_ ft.

WELL WATER TO BE USED AS:

<input checked="" type="checkbox"/> 1 Domestic	<input type="checkbox"/> 3 Feedlot	<input type="checkbox"/> 6 Oil field water supply	<input type="checkbox"/> 9 Dewatering	<input type="checkbox"/> 12 Other (Specify below)
<input type="checkbox"/> 2 Irrigation	<input type="checkbox"/> 4 Industrial	<input type="checkbox"/> 7 Lawn and garden only	<input type="checkbox"/> 10 Monitoring well	

Was a chemical/bacteriological sample submitted to Department? Yes \_\_\_\_\_ No \_\_\_\_\_; If yes, mo/day/yr sample was submitted \_\_\_\_\_

Water Well Disinfected? Yes \_\_\_\_\_ No \_\_\_\_\_

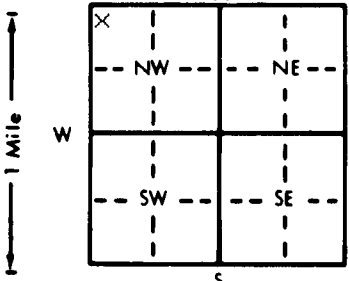

5 TYPE OF BLANK CASING USED:

<input checked="" type="checkbox"/> 1 Steel	<input type="checkbox"/> 3 RMP (SR)	<input type="checkbox"/> 5 Wrought iron	<input type="checkbox"/> 8 Concrete tile	CASING JOINTS: <input type="checkbox"/> Glued <input type="checkbox"/> Clamped
<input type="checkbox"/> 2 PVC	<input type="checkbox"/> 4 ABS	<input type="checkbox"/> 6 Asbestos-Cement	<input type="checkbox"/> 9 Other (specify below)	<input type="checkbox"/> Welded
<input type="checkbox"/> 7 Fiberglass				<input type="checkbox"/> Threaded

Blank casing diameter 5 in. to \_\_\_\_\_ ft., Dia \_\_\_\_\_ in. to \_\_\_\_\_ ft., Dia \_\_\_\_\_ in. to \_\_\_\_\_ ft.

Casing height above land surface 0 in., weight \_\_\_\_\_ lbs./ft. Wall thickness or gauge No. \_\_\_\_\_

TYPE OF SCREEN OR PERFORATION MATERIAL:

<input type="checkbox"/> 1 Steel	<input type="checkbox"/> 3 Stainless steel	<input type="checkbox"/> 5 Fiberglass	<input type="checkbox"/> 7 PVC	<input type="checkbox"/> 10 Asbestos-cement
<input type="checkbox"/> 2 Brass	<input type="checkbox"/> 4 Galvanized steel	<input type="checkbox"/> 6 Concrete tile	<input type="checkbox"/> 8 RMP (SR)	<input type="checkbox"/> 11 Other (specify)
				<input type="checkbox"/> 12 None used (open hole)

SCREEN OR PERFORATION OPENINGS ARE:

<input type="checkbox"/> 1 Continuous slot	<input type="checkbox"/> 3 Mill slot	<input type="checkbox"/> 5 Gauzed wrapped	<input type="checkbox"/> 8 Saw cut	<input type="checkbox"/> 11 None (open hole)
<input type="checkbox"/> 2 Louvered shutter	<input type="checkbox"/> 4 Key punched	<input type="checkbox"/> 6 Wire wrapped	<input type="checkbox"/> 9 Drilled holes	
		<input type="checkbox"/> 7 Torch cut	<input type="checkbox"/> 10 Other (specify)	

SCREEN-PERFORATED INTERVALS: From \_\_\_\_\_ ft. to \_\_\_\_\_ ft., From \_\_\_\_\_ ft. to \_\_\_\_\_ ft., From \_\_\_\_\_ ft. to \_\_\_\_\_ ft.

GRAVEL PACK INTERVALS: From \_\_\_\_\_ ft. to \_\_\_\_\_ ft., From \_\_\_\_\_ ft. to \_\_\_\_\_ ft., From \_\_\_\_\_ ft. to \_\_\_\_\_ ft.

6 GROUT MATERIAL:  1 Neat cement  2 Cement grout  3 Bentonite  4 Other \_\_\_\_\_

Grout Intervals: From \_\_\_\_\_ ft. to \_\_\_\_\_ ft., From \_\_\_\_\_ ft. to \_\_\_\_\_ ft., From \_\_\_\_\_ ft. to \_\_\_\_\_ ft.

What is the nearest source of possible contamination:

<input type="checkbox"/> 1 Septic tank	<input type="checkbox"/> 4 Lateral lines	<input type="checkbox"/> 7 Pit privy	<input type="checkbox"/> 10 Livestock pens	<input type="checkbox"/> 14 Abandoned water well
<input type="checkbox"/> 2 Sewer lines	<input type="checkbox"/> 5 Cess pool	<input type="checkbox"/> 8 Sewage lagoon	<input type="checkbox"/> 11 Fuel storage	<input checked="" type="checkbox"/> 15 Oil well/Gas well
<input type="checkbox"/> 3 Watertight sewer lines	<input type="checkbox"/> 6 Seepage pit	<input type="checkbox"/> 9 Feedyard	<input type="checkbox"/> 12 Fertilizer storage	<input type="checkbox"/> 16 Other (specify below)
			<input type="checkbox"/> 13 Insecticide storage	

Direction from well? South How many feet? 600 FT

FROM	TO	LITHOLOGIC LOG	FROM	TO	PLUGGING INTERVALS
			<u>38</u>	<u>11</u>	<u>Cement</u>
	<u>ENTER</u>		<u>11</u>	<u>3</u>	<u>Cement</u>
			<u>3</u>	<u>0</u>	<u>clay</u>
		<u>PLUGGING</u>			<u>Casing is 11 FT Below G.L.</u>
		<u>INFORMATION</u>			
		<u>AT</u>			<u>FEB 07 1990</u>
		<u>RIGHT</u>			<u>DIVISION OF ENVIRONMENT</u>

7 CONTRACTOR'S OR LANDOWNER'S CERTIFICATION: This water well was (1) constructed, (2) reconstructed, or (3) plugged under my jurisdiction and was completed on (mo/day/year) 1-9-90 and this record is true to the best of my knowledge and belief. Kansas Water Well Contractor's License No. 184 This Water Well Record was completed on (mo/day/yr) 1-9-90 under the business name of Schrenk 999 Drilling Inc by (signature) [Signature]

OFFICE USE ONLY  
T  
R  
EW  
SEC.  
14  
14