


1 LOCATION OF WATER WELL: County: *Cheyenne* Fraction: *SW 1/4 NW 1/4 NW 1/4* Section Number: *26'* Township Number: *T 4 S* Range Number: *R 40 W EW*

2 WATER WELL OWNER: *Sandra + Thomas Bandel*  
RR#, St. Address, Box #: *R 2 Box 124*  
City, State, ZIP Code: *St. Francis Kan 67256*

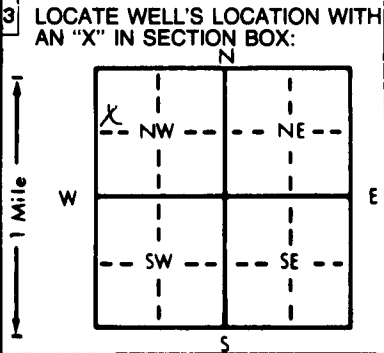

4 DEPTH OF COMPLETED WELL: *15.0* ft. ELEVATION:  
Depth(s) Groundwater Encountered 1. . . . . ft. 2. . . . . ft. 3. . . . . ft.  
WELL'S STATIC WATER LEVEL *Dry Hole* ft. below land surface measured on mo/day/yr . . . . .  
Pump test data: Well water was . . . . . ft. after . . . . . hours pumping . . . . . gpm  
Est. Yield . . . . . gpm: Well water was . . . . . ft. after . . . . . hours pumping . . . . . gpm  
Bore Hole Diameter . . . . . in. to . . . . . ft., and . . . . . in. to . . . . . ft.  
WELL WATER TO BE USED AS:  
① Domestic 3 Feedlot 6 Oil field water supply 9 Dewatering 12 Other (Specify below)  
2 Irrigation 4 Industrial 7 Lawn and garden only 10 Monitoring well . . . . .  
Was a chemical/bacteriological sample submitted to Department? Yes . . . . . No . . . . . ; If yes, mo/day/yr sample was submitted . . . . .

5 TYPE OF BLANK CASING USED:  
1 Steel 3 RMP (SR) 5 Wrought iron 8 Concrete tile CASING JOINTS: Glued . . . . . Clamped . . . . .  
2 PVC 4 ABS 6 Asbestos-Cement 9 Other (specify below) Welded . . . . .  
Blank casing diameter . . . . . in. to . . . . . ft., Dia . . . . . in. to . . . . . ft., Dia . . . . . in. to . . . . . ft.  
Casing height above land surface . . . . . in., weight . . . . . lbs./ft. Wall thickness or gauge No. . . . .  
TYPE OF SCREEN OR PERFORATION MATERIAL:  
1 Steel 3 Stainless steel 5 Fiberglass 7 PVC 10 Asbestos-cement  
2 Brass 4 Galvanized steel 6 Concrete tile 8 RMP (SR) 11 Other (specify) . . . . .  
SCREEN OR PERFORATION OPENINGS ARE:  
1 Continuous slot 3 Mill slot 5 Gauzed wrapped 8 Saw cut 11 None (open hole)  
2 Louvered shutter 4 Key punched 6 Wire wrapped 9 Drilled holes  
SCREEN-PERFORATED INTERVALS: From . . . . . ft. to . . . . . ft., From . . . . . ft. to . . . . . ft.  
GRAVEL PACK INTERVALS: From . . . . . ft. to . . . . . ft., From . . . . . ft. to . . . . . ft.

6 GROUT MATERIAL: 1 Neat cement 2 Cement grout 3 Bentonite 4 Other . . . . .  
Grout Intervals: From . . . . . *3* ft. to . . . . . *1.0* ft., From . . . . . ft. to . . . . . ft., From . . . . . ft. to . . . . . ft.  
What is the nearest source of possible contamination:  
1 Septic tank 4 Lateral lines 7 Pit privy 10 Livestock pens 14 Abandoned water well  
2 Sewer lines 5 Cess pool 8 Sewage lagoon 11 Fuel storage 15 Oil well/Gas well  
3 Watertight sewer lines 6 Seepage pit 9 Feedyard 12 Fertilizer storage 16 Other (specify below)  
Direction from well? *South west* How many feet? *1300*

FROM	TO	LITHOLOGIC LOG	FROM	TO	PLUGGING INTERVALS
			<i>15.0</i>	<i>10</i>	<i>Removed upper 3ft of casing Clay Cement grout SURFACE Clay</i>
			<i>10</i>	<i>3</i>	
			<i>3</i>	<i>0</i>	
					<i>APR 30 1990</i>
					<i>DIVISION OF ENVIRONMENT</i>

7 CONTRACTOR'S OR LANDOWNER'S CERTIFICATION: This water well was (1) constructed, (2) reconstructed, or (3) plugged under my jurisdiction and was completed on (mo/day/year) *4-12-90* and this record is true to the best of my knowledge and belief. Kansas Water Well Contractor's License No. . . . . This Water Well Record was completed on (mo/day/yr) *4-12-90* under the business name of . . . . . by (signature) *Thomas L Bandel*

OFFICE USE ONLY  
T  
R  
EW  
SEC  
1/4  
1/4  
1/4