

USE TYPEWRITER OR BALL POINT PEN-PRESS FIRMLY, PRINT CLEARLY.


*BRAC CBC*

WATER WELL RECORD  
KSA 82-1201-1215

Kansas Department of Health and Environment-Division of Environment  
(Water well Contractors)  
Topeka, Kansas 66620

1. Location of well:	County <b>Cheyenne</b>	Fraction <b>SW 1/4 SW 1/4NW 1/4</b>	Section number <b>29</b>	Township number <b>T 4 S</b>	Range number <b>R 40 E</b>
----------------------	---------------------------	--	-----------------------------	---------------------------------	-------------------------------

2. Distance and direction from nearest town or city: <b>4 1/2 south, 1/4 east of St. Francis.</b> Street address of well location if in city:	3. Owner of well: <b>Swede Calnon</b> R.R. or street: <b>St. Francis, Kansas 67756</b> City, state, zip code:
---	--

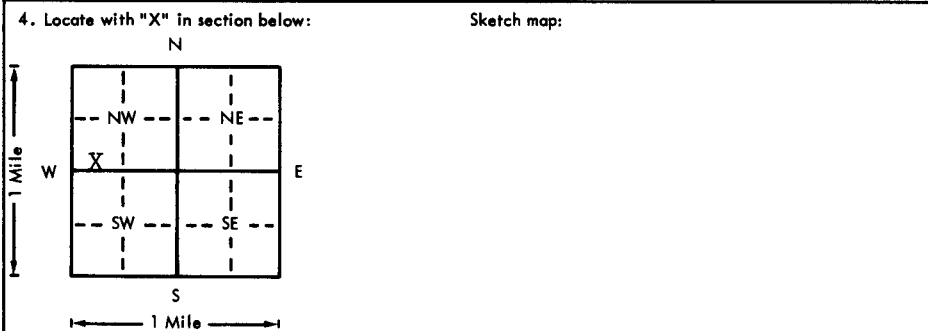

6. Bore hole dig. **28** m. Completion date **6-17-76**  
Well depth **267** ft.

7. Cable tool  Rotary  Driven  Dug  
 Hollow rod  Jetted  Bored  Reverse rotary

8. Use:  Domestic  Public supply  Industry  
 Irrigation  Air conditioning  Stock  
 Lawn  Oil field water  Other

9. Casing: Material **Steel** Height: Above or below **XXX**  
Threaded  Welded  Surface **12** in.  
RMP  PVC  Weight **188** lbs./ft.  
Dia. **16** in. to **267** ft. depth Wall Thickness: inches or  
Dia.  in. to  ft. depth gage No. **7**

5. Type and color of material	From	To
Clay and sand and gravel	0	112
Clay and cement	112	119
Fine Course sand and gravel	119	133
Fine Course sand, cement streaks	133	143
Fine Course sand	143	154
Fine Course sand and cement streaks	154	169
Sandy Clay and cement streaks	169	187
Clay, cement streaks	187	196
Clay	196	242
Medium coarse sand and gravel	242	257
Clay	257	258
Sand	258	259
Sandstone	259	260
Course sand and gravel	260	265
Ochre and shale	265	275

10. Screen: Manufacturer's name **W.A. Brown**  
Type **Free Flo** Dia. **16"**  
Slot/gauze **3/16** Length **3'**  
Set between **197** ft. and **257** ft.  
ft. and  ft.  
Gravel pack? **Yes** Size range of material **Slot**

11. Static water level: **176** ft. below land surface Date **6-21-76** mg./day/yr.

12. Pumping level below land surfaces:  
**260** ft. after **2** hrs. pumping **297** g.p.m.  
ft. after  hrs. pumping  g.p.m.  
Estimated maximum yield **225** g.p.m.

13. Water sample submitted:  Yes  No Date

14. Well head completion:  
 Pitless adapter  **12** inches above grade

15. Well grouted?  **& Clay**  
With:  Neat cement  Bentonite  Concrete  
Depth: From **10** ft. to **0** ft.

16. Nearest source of possible contamination:  
ft.  Direction **none apparent**  
Well disinfected upon completion?  Yes  No

17. Pump:  Not installed  
Manufacturer's name **Johnston**  
Model number  HP  Volts   
Length of drop pipe **250** ft. capacity **225** g.p.m.  
Type:  
 Submersible  Turbine  
 Jet  Reciprocating  
 Centrifugal  Other

18. Elevation:  Topography: <input type="checkbox"/> Hill <input checked="" type="checkbox"/> Slope <input type="checkbox"/> Upland <input type="checkbox"/> Valley	19. Remarks:  <b>3594 (TOP)</b> <b>3594</b> <b>BRICK 265'</b> (Use a second sheet if needed)
---	---

20. Water well contractor's certification:  
This well was drilled under my jurisdiction and this report is true to the best of my knowledge and belief.  
**Western Well and Pump, Inc**  
Business name License No.   
Address **Box 852 Colby, Kansas**  
Signed **Roy Senior by Job** Date **7-21-76**  
Authorized representative

T-47403-275