

USE TYPEWRITER OR BALL POINT PEN-PRESS FIRMLY, PRINT CLEARLY.


WATER WELL RECORD
KSA 82a-1201-1215

Kansas Department of Health and Environment-Division of Environment (Water well Contractors) Topeka, Kansas 66620

CCC

1. Location of well: County **Cheyenne** Fraction **SW 1/4 SW 1/4 SW 1/4** Section number **19** Township number **T 4 S R 41 E 10**

2. Distance and direction from nearest town or city: **SW of St. Francis** 3. Owner of well: **Mrs. Harvey Oschner**
Street address of well location if in city: **up Road River** R.R. or street: _____
City, state, zip code: **Burlington, CO 80807**

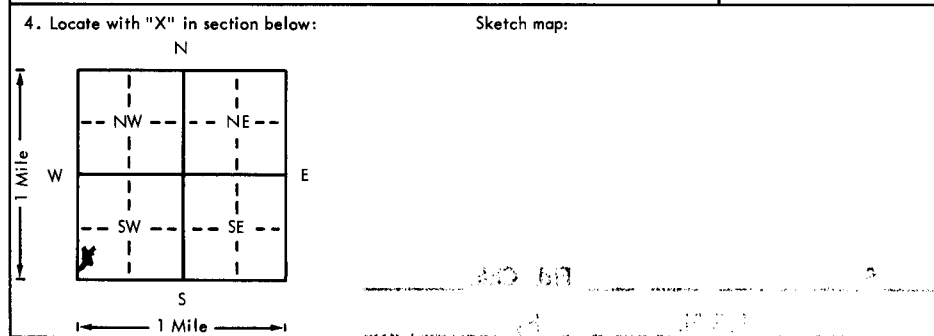

6. Bore hole dia. **28** in. Completion date **8-9-78**
Well depth **34** ft.

7. Cable tool Rotary Driven Dug
 Hollow rod Jetted Bored Reverse rotary

8. Use: Domestic Public supply Industry
 Irrigation Air conditioning Stock
 Lawn Oil field water Other

9. Casing: Material **Steel** Height: Above or below
Threaded Welded Surface **12** in.
RMP: PVC Weight _____ lbs./ft.
Dia. **16** in. to **34** ft. depth Wall Thickness: inches or
Dia. _____ in. to _____ ft. depth gage No. **3/16"**

5. Type and color of material	From	To
Top Soil	0	11
Sand & Gravel (Medium)	11	20
Coarse Gravel	20	26
Coarse Gravel & Shale	26	34
BROCK 37'		

10. Screen: Manufacturer's name _____
20' Cook Screen
Type **wire** Dia. **16"**
Slot/gauze **50** Length **20'**
Set between **14** ft. and **34** ft.
ft. and _____ ft.

Gravel pack? Size range of material _____

11. Static water level: _____ mo./day/yr.
12 ft. below land surface Date **8-9-78**

12. Pumping level below land surfaces:
30 ft. after **2** hrs. pumping **500** g.p.m.
_____ ft. after _____ hrs. pumping _____ g.p.m.
Estimated maximum yield **502 total draw down**

13. Water sample submitted: _____ mo./day/yr.
Yes No Date _____

14. Well head completion:
 Pitless adapter **12** Inches above grade

15. Well grouted?
With: Neat cement Bentonite Concrete
Depth: From **0** ft. to **10** ft.

16. Nearest source of possible contamination:
ft. **600** Direction **W** Type **Farmstead**
Well disinfected upon completion? Yes No

17. Pump: _____ Not installed
Manufacturer's name **WLR**
Model number **10CH** HP **30** Volts _____
Length of drop pipe **32** ft. capacity **500** g.p.m.
Type:
 Submersible Turbine
 Jet Reciprocating
 Centrifugal Other

18. Elevation:
Topography:
 Hill
 Slope
 Upland
 Valley

19. Remarks:

(Use a second sheet if needed)

20. Water well contractor's certification:
This well was drilled under my jurisdiction and this report is true to the best of my knowledge and belief.
Western Well & Pump, Inc. 245
Business name License No. _____
Address **Box 852 Colby, KS 67701**
Signed **Jerry Mollering** Date **8-9-78**
Authorized representative

T 4
R 41
W
Sec 19
SW SW SW
1/4 1/4 1/4