


1 LOCATION OF WATER WELL: County: Cherokee Fraction: SW 1/4 NE 1/4 SW 1/4 Section Number: 23 Township Number: T 4 S Range Number: R 41 E/W
 Distance and direction from nearest town or city street address of well if located within city?:
5 South Street of St. Francis KS.

2 WATER WELL OWNER: John Lindsten
 RR#, St. Address, Box #: _____ Board of Agriculture, Division of Water Resources
 City, State, ZIP Code: St. Francis, KS Application Number: _____

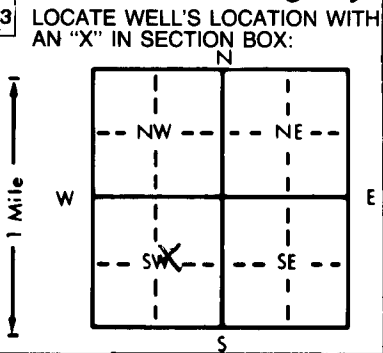

4 DEPTH OF COMPLETED WELL: 170 ft. ELEVATION: 3500
 Depth(s) Groundwater Encountered 1. 146 ft. 2. _____ ft. 3. _____ ft.
 WELL'S STATIC WATER LEVEL: 146 ft. below land surface measured on mo/day/yr 6-11-90
 Pump test data: Well water was _____ ft. after _____ hours pumping _____ gpm
 Est. Yield: 10 gpm: Well water was _____ ft. after _____ hours pumping _____ gpm
 Bore Hole Diameter: 7 in. to 170 ft., and _____ in. to _____ ft.
 WELL WATER TO BE USED AS:
 1 Domestic 3 Feedlot 6 Oil field water supply 9 Dewatering 12 Other (Specify below)
 2 Irrigation 4 Industrial 7 Lawn and garden only 10 Monitoring well
 Was a chemical/bacteriological sample submitted to Department? Yes _____ No X; If yes, mo/day/yr sample was submitted _____
 Water Well Disinfected? Yes X No _____

5 TYPE OF BLANK CASING USED:
 1 Steel 3 RMP (SR) 5 Wrought iron 8 Concrete tile CASING JOINTS: Glued X Clamped _____
 2 PVC 4 ABS 6 Asbestos-Cement 9 Other (specify below) Welded _____
 7 Fiberglass Threaded _____
 Blank casing diameter: 4 in. to 160 ft., Dia _____ in. to _____ ft., Dia _____ in. to _____ ft.
 Casing height above land surface: 14 in., weight 184 lbs./ft. Wall thickness or gauge No. SDR 21
 TYPE OF SCREEN OR PERFORATION MATERIAL:
 1 Steel 3 Stainless steel 5 Fiberglass 8 RMP (SR) 10 Asbestos-cement
 2 Brass 4 Galvanized steel 6 Concrete tile 9 ABS 11 Other (specify) _____
 12 None used (open hole)
 SCREEN OR PERFORATION OPENINGS ARE:
 1 Continuous slot 3 Mill slot 5 Gauzed wrapped 8 Saw cut 11 None (open hole)
 2 Louvered shutter 4 Key punched 6 Wire wrapped 9 Drilled holes
 7 Torch cut 10 Other (specify) _____
 SCREEN-PERFORATED INTERVALS: From 160 ft. to 170 ft., From _____ ft. to _____ ft.
 GRAVEL PACK INTERVALS: From 170 ft. to 30 ft., From _____ ft. to _____ ft.

6 GROUT MATERIAL: 1 Neat cement 2 Cement grout 3 Bentonite 4 Other _____
 Grout Intervals: From 0 ft. to 20 ft., From 20 ft. to 30 ft., From _____ ft. to _____ ft.
 What is the nearest source of possible contamination: N.A. in pasture
 1 Septic tank 4 Lateral lines 7 Pit privy 10 Livestock pens 14 Abandoned water well
 2 Sewer lines 5 Cess pool 8 Sewage lagoon 11 Fuel storage 15 Oil well/Gas well
 3 Watertight sewer lines 6 Seepage pit 9 Feedyard 12 Fertilizer storage 16 Other (specify below)
 13 Insecticide storage
 Direction from well? _____ How many feet? _____

FROM	TO	LITHOLOGIC LOG	FROM	TO	PLUGGING INTERVALS
0	3	Top Soil			
3	47	Clay			
47	64	Sandy clay			
64	66	Rock			
66	94	S&G Gravel some clay			
94	95	Rock			
95	109	Sand			
109	117	Clay			
117	143	Sand with layers of clay			
143	154	Sand & Gravel			
154	157	Sand Rock			
157	172	Sand & Gravel with clay			

7 CONTRACTOR'S OR LANDOWNER'S CERTIFICATION: This water well was (1) constructed (2) reconstructed, or (3) plugged under my jurisdiction and was completed on (mo/day/year) 6-11-90 and this record is true to the best of my knowledge and belief. Kansas Water Well Contractor's License No. 184 This Water Well Record was completed on (mo/day/yr) 2 June 90 under the business name of Schoen Ridge Drilling Inc by (signature) [Signature]

OFFICE USE ONLY
T
R
EW
SEC.
1/4
1/4