WATER WELL RECORD Form WWC-5 KSA 82a-1212

1 LOCATION OF WATER WELL: County: Cheyenne | Fraction: SE ¼ NE ¼ SW ¼ | Section Number: 25 | Township Number: T 4S | Range Number: R 41 E(W)

Distance and direction from nearest town or city street address of well if located within city?
4 West 6 South of St. Francis Kansas

2 WATER WELL OWNER: Link Zweygardt
RR#, St. Address, Box # :
City, State, ZIP Code : St. Francis, KS 67756

Board of Agriculture, Division of Water Resources
Application Number:

3 LOCATE WELL'S LOCATION WITH AN "X" IN SECTION BOX:

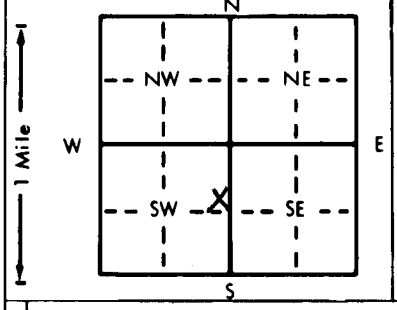

4 DEPTH OF COMPLETED WELL 163 ft. ELEVATION:
Depth(s) Groundwater Encountered 1. 108 ft. 2. ft. 3. ~~6-24-82~~ ft.
WELL'S STATIC WATER LEVEL 108 ft. below land surface measured on mo/day/yr 6-24-82
Pump test data: Well water was ft. after hours pumping gpm
Est. Yield 15 gpm: Well water was ft. after hours pumping gpm
Bore Hole Diameter 8 in. to 163 ft., and in. to ft.
WELL WATER TO BE USED AS: 5 Public water supply 8 Air conditioning 11 Injection well
(1) Domestic 3 Feedlot 6 Oil field water supply 9 Dewatering 12 Other (Specify below)
2 Irrigation 4 Industrial 7 Lawn and garden only 10 Observation well Pasture
Was a chemical/bacteriological sample submitted to Department? Yes No (1) If yes, mo/day/yr sample was submitted
Water Well Disinfected? (Yes) No

5 TYPE OF BLANK CASING USED: 1 Steel 3 RMP (SR) 5 Wrought iron 6 Asbestos-Cement 8 Concrete tile 9 Other (specify below) 7 Fiberglass
(2 PVC) 4 ABS
CASING JOINTS: (Glued) Clamped Welded Threaded
Blank casing diameter 5 in. to 153 ft., Dia in. to ft., Dia in. to ft.
Casing height above land surface 12 in., weight lbs./ft. Wall thickness or gauge No. SDR 21

TYPE OF SCREEN OR PERFORATION MATERIAL: (7 PVC)
1 Steel 3 Stainless steel 5 Fiberglass 8 RMP (SR) 10 Asbestos-cement
2 Brass 4 Galvanized steel 6 Concrete tile 9 ABS 11 Other (specify) 12 None used (open hole)

SCREEN OR PERFORATION OPENINGS ARE: 5 Gauzed wrapped 8 Saw cut 11 None (open hole)
1 Continuous slot (3 Mill slot) 6 Wire wrapped 9 Drilled holes
2 Louvered shutter 4 Key punched 7 Torch cut 10 Other (specify)

SCREEN-PERFORATED INTERVALS: From 153 ft. to 163 ft., From ft. to ft.
From ft. to ft., From ft. to ft.
GRAVEL PACK INTERVALS: From ft. to ft., From ft. to ft.
From ft. to ft., From ft. to ft.

6 GROUT MATERIAL: (1 Neat cement) 2 Cement grout 3 Bentonite 4 Other
Grout Intervals: From 0 ft. to 10 ft., From ft. to ft., From ft. to ft.

What is the nearest source of possible contamination:
1 Septic tank 4 Lateral lines 7 Pit privy 10 Livestock pens 14 Abandoned water well
2 Sewer lines 5 Cess pool 8 Sewage lagoon 11 Fuel storage 15 Oil well/Gas well
3 Watertight sewer lines 6 Seepage pit 9 Feedyard 12 Fertilizer storage 16 Other (specify below)
13 Insecticide storage None in Pasture
Direction from well? How many feet?

FROM	TO	LITHOLOGIC LOG	FROM	TO	LITHOLOGIC LOG
0	3	Top Soil			
3	64	Clay			
64	69	Sand Rock - Clay			
69	70	Rock			
70	106	Sandy clay - Sand			
106	107	Rock			
107	111	Sand & Gravel			
111	134	Sand & Gravel layers of Clay			
134	136	Rock			
136	141	Sand Rock			
141	163	Sand - Gravel -			
163	167	Shale			

7 CONTRACTOR'S OR LANDOWNER'S CERTIFICATION: This water well was (1) constructed, (2) reconstructed, or (3) plugged under my jurisdiction and was completed on (mo/day/year) 6-24-82 and this record is true to the best of my knowledge and belief. Kansas Water Well Contractor's License No. 184 B This Water Well Record was completed on (mo/day/yr) 12-2-82 under the business name of Schoenrogge Drilling Inc by (signature) Gilbert Schwegg

INSTRUCTIONS: Use typewriter or ball point pen. *PLEASE PRESS FIRMLY* and *PRINT* clearly. Please fill in blanks, underline or circle the correct answers. Send top three copies to Kansas Department of Health and Environment, Division of Environment, Environmental Geology Section, Topeka, KS 66620. Send one to WATER WELL OWNER and retain one for your records.

OFFICE USE ONLY
T 4 R 41 E(W) SEC. 25 SE¼ NE¼ SW¼