

WATER WELL RECORD Form WWC-5 KSA 82a-1212


| | | | | |
|--|---|----------------------------|---------------------------------|----------------------------------|
| 1 LOCATION OF WATER WELL: County: <u>Cheyenne</u> | Fraction <u>NE 1/4 NE 1/4 NE 1/4</u> | Section Number <u>2</u> | Township Number <u>T 4 S</u> | Range Number <u>R 42 W EW</u> |
|--|---|----------------------------|---------------------------------|----------------------------------|

Distance and direction from nearest town or city street address of well if located within city?

N/A - LOCATION CONFIRMED BY GMD #4

2 WATER WELL OWNER: Royce E. Stimbert
 RR#, St. Address, Box # : HC 1 Box 49
 City, State, ZIP Code : St. Francis, KS 67756
 Board of Agriculture, Division of Water Resources
 Application Number:

3 LOCATE WELL'S LOCATION WITH AN "X" IN SECTION BOX:

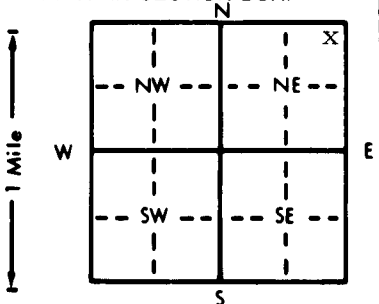

4 DEPTH OF COMPLETED WELL... 155 ft. ELEVATION:

Depth(s) Groundwater Encountered 1 ft. 2. ft. 3. ft.

WELL'S STATIC WATER LEVEL... DRY ft. below land surface measured on mo/day/yr

Pump test data: Well water was ft. after hours pumping gpm

Est. Yield gpm: Well water was ft. after hours pumping gpm

Bore Hole Diameter in. to ft., and in. to ft.

WELL WATER TO BE USED AS:

| | | | | |
|--|---------------------------------------|---|---|---|
| <input checked="" type="checkbox"/> 1 Domestic | <input type="checkbox"/> 3 Feedlot | <input type="checkbox"/> 6 Oil field water supply | <input type="checkbox"/> 9 Dewatering | <input type="checkbox"/> 12 Other (Specify below) |
| <input type="checkbox"/> 2 Irrigation | <input type="checkbox"/> 4 Industrial | <input type="checkbox"/> 7 Lawn and garden only | <input type="checkbox"/> 10 Monitoring well | |

5 Public water supply 8 Air conditioning 11 Injection well

Was a chemical/bacteriological sample submitted to Department? Yes.....No.....; If yes, mo/day/yr sample was submitted

Water Well Disinfected? Yes No

5 TYPE OF BLANK CASING USED:

| | | | | |
|---|-------------------------------------|--|--|--|
| <input checked="" type="checkbox"/> Steel | <input type="checkbox"/> 3 RMP (SR) | <input type="checkbox"/> 5 Wrought iron | <input type="checkbox"/> 8 Concrete tile | CASING JOINTS: Glued Clamped |
| <input type="checkbox"/> 2 PVC | <input type="checkbox"/> 4 ABS | <input type="checkbox"/> 6 Asbestos-Cement | <input type="checkbox"/> 9 Other (specify below) | Welded |
| | | <input type="checkbox"/> 7 Fiberglass | | Threaded |

Blank casing diameter 5 in. to ft., Dia in. to ft., Dia in. to ft.

Casing height above land surface 15 in., weight lbs./ft. Wall thickness or gauge No.

TYPE OF SCREEN OR PERFORATION MATERIAL:

| | | | | |
|----------------------------------|---|--|-------------------------------------|---|
| <input type="checkbox"/> 1 Steel | <input type="checkbox"/> 3 Stainless steel | <input type="checkbox"/> 5 Fiberglass | <input type="checkbox"/> 7 PVC | <input type="checkbox"/> 10 Asbestos-cement |
| <input type="checkbox"/> 2 Brass | <input type="checkbox"/> 4 Galvanized steel | <input type="checkbox"/> 6 Concrete tile | <input type="checkbox"/> 8 RMP (SR) | <input type="checkbox"/> 11 Other (specify) |
| | | | <input type="checkbox"/> 9 ABS | <input type="checkbox"/> 12 None used (open hole) |

SCREEN OR PERFORATION OPENINGS ARE:

| | | | | |
|---|--|---|---|--|
| <input type="checkbox"/> 1 Continuous slot | <input type="checkbox"/> 3 Mill slot | <input type="checkbox"/> 5 Gauzed wrapped | <input type="checkbox"/> 8 Saw cut | <input type="checkbox"/> 11 None (open hole) |
| <input type="checkbox"/> 2 Louvered shutter | <input type="checkbox"/> 4 Key punched | <input type="checkbox"/> 6 Wire wrapped | <input type="checkbox"/> 9 Drilled holes | |
| | | <input type="checkbox"/> 7 Torch cut | <input type="checkbox"/> 10 Other (specify) | |

SCREEN-PERFORATED INTERVALS: From ft. to ft., From ft. to ft.

GRAVEL PACK INTERVALS: From ft. to ft., From ft. to ft.

6 GROUT MATERIAL: 1 Neat cement 2 Cement grout 3 Bentonite 4 Other

Grout Intervals: From 5 ft. to 2 ft., From ft. to ft., From ft. to ft.

What is the nearest source of possible contamination: Well was Dry

| | | | | |
|---|--|--|---|---|
| <input type="checkbox"/> 1 Septic tank | <input type="checkbox"/> 4 Lateral lines | <input type="checkbox"/> 7 Pit privy | <input type="checkbox"/> 10 Livestock pens | <input type="checkbox"/> 14 Abandoned water well |
| <input type="checkbox"/> 2 Sewer lines | <input type="checkbox"/> 5 Cess pool | <input type="checkbox"/> 8 Sewage lagoon | <input type="checkbox"/> 11 Fuel storage | <input type="checkbox"/> 15 Oil well/Gas well |
| <input type="checkbox"/> 3 Watertight sewer lines | <input type="checkbox"/> 6 Seepage pit | <input type="checkbox"/> 9 Feedyard | <input type="checkbox"/> 12 Fertilizer storage | <input type="checkbox"/> 16 Other (specify below) |
| | | | <input type="checkbox"/> 13 Insecticide storage | |

Direction from well? How many feet?

| FROM | TO | LITHOLOGIC LOG | FROM | TO | PLUGGING INTERVALS |
|------|----------|----------------|------------|------------|--------------------------|
| | ENTER | | | | |
| | | | <u>155</u> | <u>130</u> | <u>GRAVEL & SAND</u> |
| | | | <u>130</u> | <u>5</u> | <u>CLAY</u> |
| | PLUGGING | | <u>5</u> | <u>2</u> | <u>Cement</u> |
| | | | <u>2</u> | <u>0</u> | <u>Surface Clay</u> |
| | | INFORMATION | | | |
| | | AT | | | |
| | | RIGHT | | | |

RECEIVED

NOV 30 1989

DIVISION OF ENVIRONMENT

7 CONTRACTOR'S OR LANDOWNER'S CERTIFICATION: This water well was (1) constructed, (2) reconstructed, or (3) plugged under my jurisdiction and was completed on (mo/day/year) and this record is true to the best of my knowledge and belief. Kansas Water Well Contractor's License No. This Water Well Record was completed on (mo/day/yr) 10/30/89 under the business name of by (signature) Royce Stimbert