


1 LOCATION OF WATER WELL: County: **CHEYENNE** Fraction: **SE 1/4 SE 1/4 SE 1/4** Section Number: **2** Township Number: **T 4 S** Range Number: **R 42 E**
 Distance and direction from nearest town or city street address of well if located within city?

2 WATER WELL OWNER: **ROYCE STEMBERT** 913-332-2410
 RR#, St. Address, Box #: **HC1 BOX 49** Board of Agriculture, Division of Water Resources
 City, State, ZIP Code: **ST. FRANCIS KAN 67756** Application Number:

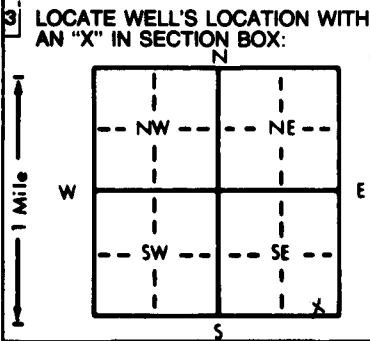

4 DEPTH OF COMPLETED WELL: **143** ft. ELEVATION: ft.
 Depth(s) Groundwater Encountered 1. ft. 2. ft. 3. ft.
 WELL'S STATIC WATER LEVEL: **120 (DRY)** below land surface measured on mo/day/yr
 Pump test data: Well water was ft. after hours pumping gpm
 Est. Yield gpm: Well water was ft. after hours pumping gpm
 Bore Hole Diameter in. to ft., and in. to ft.
 WELL WATER TO BE USED AS:
 1 Domestic 2 Irrigation 3 Feedlot 4 Industrial
 5 Public water supply 6 Oil field water supply 7 Lawn and garden only
 8 Air conditioning 9 Dewatering 10 Monitoring well
 11 Injection well 12 Other (Specify below)
 Was a chemical/bacteriological sample submitted to Department? Yes.....No.....X.....; If yes, mo/day/yr sample was submitted
 Water Well Disinfected? Yes No

5 TYPE OF BLANK CASING USED:
 1 Steel 2 PVC 3 RMP (SR) 4 ABS
 5 Wrought iron 6 Asbestos-Cement 7 Fiberglass
 8 Concrete tile 9 Other (specify below)
 Casing diameter in. to ft., Dia in. to ft., Dia in. to ft.
 Casing height above land surface in., weight lbs./ft. Wall thickness or gauge No.
 TYPE OF SCREEN OR PERFORATION MATERIAL:
 1 Steel 2 Brass 3 Stainless steel 4 Galvanized steel
 5 Fiberglass 6 Concrete tile 7 PVC 8 RMP (SR)
 9 ABS 10 Asbestos-cement 11 Other (specify)
 12 None used (open hole)
 SCREEN OR PERFORATION OPENINGS ARE:
 1 Continuous slot 2 Louvered shutter 3 Mill slot 4 Key punched
 5 Gauzed wrapped 6 Wire wrapped 7 Torch cut 8 Saw cut 9 Drilled holes 10 Other (specify)
 11 None (open hole)
 SCREEN-PERFORATED INTERVALS: From ft. to ft., From ft. to ft.
 GRAVEL PACK INTERVALS: From ft. to ft., From ft. to ft.

6 GROUT MATERIAL: 1 Neat cement 2 Cement grout 3 Bentonite 4 Other
 Grout Intervals: From **3** ft. to **6** ft., From ft. to ft., From ft. to ft.
 What is the nearest source of possible contamination: **well was dry**
 1 Septic tank 2 Sewer lines 3 Watertight sewer lines
 4 Lateral lines 5 Cess pool 6 Seepage pit
 7 Pit privy 8 Sewage lagoon 9 Feedyard
 10 Livestock pens 11 Fuel storage 12 Fertilizer storage 13 Insecticide storage
 14 Abandoned water well 15 Oil well/Gas well 16 Other (specify below)

Direction from well? How many feet?

FROM	TO	LITHOLOGIC LOG	FROM	TO	PLUGGING INTERVALS
			143	120	Gravel + SAND
			120	6'	CLAY
			6'	3	Cement
			3	0	Surface Clay

RECEIVED

NOV 30 1989

DIVISION OF ENVIRONMENT

7 CONTRACTOR'S OR LANDOWNER'S CERTIFICATION: This water well was (1) constructed, (2) reconstructed, or (3) plugged under my jurisdiction and was completed on (mo/day/year) and this record is true to the best of my knowledge and belief. Kansas
 Water Well Contractor's License No. This Water Well Record was completed on (mo/day/yr) **10-30-89**
 under the business name of by (signature) **Royce Stembert**

OFFICE USE ONLY
T
R
EW
SEC.