


USE TYPEWRITER OR BALL POINT PEN-PRESS FIRMLY, PRINT CLEARLY.

WATER WELL RECORD  
KSA 82a-1201-1215

Kansas Department of Health and Environment-Division of Environment  
(Water well Contractors)  
Topeka, Kansas 66620

1. Location of well: County Cheyenne Fraction NE 1/4 SW 1/4 SW 1/4 Section number 4 Township number T 4 S R 42 W Range number 42 W

2. Distance and direction from nearest town or city: 1 1/2 West 3. Owner of well: Paul Raitle  
Street address of well location if in city: 250 of St. Francis R.R. or street:  
City, state, zip code: St. Francis, Kansas

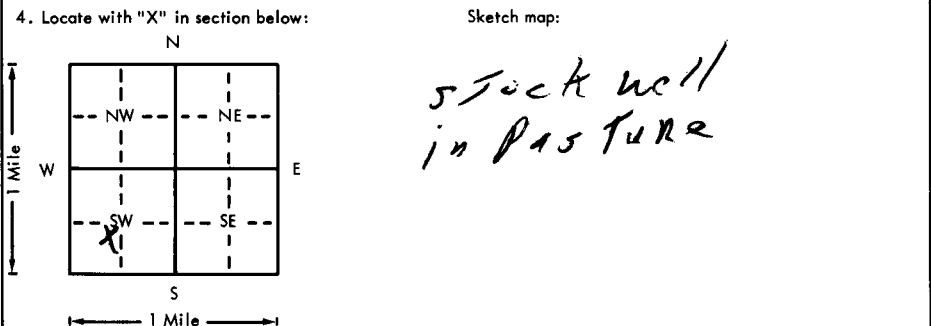

6. Bore hole dia. 3 in. Completion date 21 June 77  
Well depth 218 ft.

7. Cable tool  Rotary  Driven  Dug  
 Hollow rod  Jetted  Bored  Reverse rotary

8. Use:  Domestic  Public supply  Industry  
 Irrigation  Air conditioning  Stock  
 Lawn  Oil field water  Other

9. Casing: Material PTX Height: Above or below  
Threaded  Welded GL Surface 12 in.  
RMP  PVC Weight \_\_\_\_\_ lbs./ft.  
Dia. 3 in. to 198 ft. depth Wall Thickness: inches or  
Dia. \_\_\_\_\_ in. to \_\_\_\_\_ ft. depth gage No. .250

5. Type and color of material	From	To
<u>Top Soil</u>	<u>0</u>	<u>2</u>
<u>Clay</u>	<u>2</u>	<u>73</u>
<u>S+M</u>	<u>73</u>	<u>115</u>
<u>Rock</u>	<u>115</u>	<u>116</u>
<u>CLAY</u>	<u>116</u>	<u>123</u>
<u>S+M SR</u>	<u>123</u>	<u>130</u>
<u>S+M CLAY</u>	<u>130</u>	<u>151</u>
<u>S+M SR CLAY</u>	<u>151</u>	<u>177</u>
<u>SR</u>	<u>177</u>	<u>179</u>
<u>S+M - SR</u>	<u>179</u>	<u>183</u>
<u>CLAY</u>	<u>183</u>	<u>186</u>
<u>S+M SR</u>	<u>186</u>	<u>197</u>
<u>S+M</u>	<u>197</u>	<u>208</u>
<u>S+M CLAY</u>	<u>208</u>	<u>212</u>
<u>Shale</u>	<u>212</u>	<u>218</u>
<u>Stock SR</u>		

10. Screen: Manufacturer's name J & L  
Type \_\_\_\_\_ Dia. 5"  
Slot/gauze \_\_\_\_\_ Length 20'  
Set between 1 1/8 ft. and 2 1/8 ft.  
ft. and \_\_\_\_\_ ft.  
Gravel pack?  Size range of material 1/8"

11. Static water level: \_\_\_\_\_ mo./day/yr.  
161 ft. below land surface Date 21 June 77

12. Pumping level below land surfaces:  
\_\_\_\_\_ ft. after \_\_\_\_\_ hrs. pumping \_\_\_\_\_ g.p.m.  
\_\_\_\_\_ ft. after \_\_\_\_\_ hrs. pumping \_\_\_\_\_ g.p.m.  
Estimated maximum yield \_\_\_\_\_ g.p.m.

13. Water sample submitted: \_\_\_\_\_ mo./day/yr.  
Yes  No  Date \_\_\_\_\_

14. Well head completion:  
 Pitless adapter \_\_\_\_\_ Inches above grade

15. Well grouted?   
With:  Neat cement  Bentonite  Concrete  
Depth: From 0 ft. to 11 ft.

16. Nearest source of possible contamination:  
ft. \_\_\_\_\_ direction \_\_\_\_\_ Type \_\_\_\_\_  
Well disinfected upon completion?  Yes  No

17. Pump:  Not installed  
Manufacturer's name \_\_\_\_\_  
Model number \_\_\_\_\_ HP \_\_\_\_\_ Volts \_\_\_\_\_  
Length of drop pipe \_\_\_\_\_ ft. capacity \_\_\_\_\_ g.p.m.  
Type:  
 Submersible  Turbine  
 Jet  Reciprocating  
 Centrifugal  Other

18. Elevation: \_\_\_\_\_  
19. Remarks: \_\_\_\_\_  
Topography:  
 Hill  
 Slope  
 Upland  
 Valley

20. Water well contractor's certification:  
This well was drilled under my jurisdiction and this report is true to the best of my knowledge and belief.  
Schoenroge Drilling Co. 184B  
Business name License No. \_\_\_\_\_  
Address St. Francis, Kansas  
Signed [Signature] Date [Date]  
Authorized representative

T  
 4  
 R  
 42  
 W  
 E  
 4  
 NE SW  
 Sec