


1 LOCATION OF WATER WELL: Fraction SE 1/4 SE 1/4 SE 1/4 Section Number 15 Township Number T 4 S Range Number R 42 EW

Distance and direction from nearest town or city street address of well if located within city?
15 south west of ST. Francis

2 WATER WELL OWNER: Jacob Wilkening
RR#, St. Address, Box #: HCR 3 Box 46 Board of Agriculture, Division of Water Resources
City, State, ZIP Code: Goodland, KS 67735 Application Number:

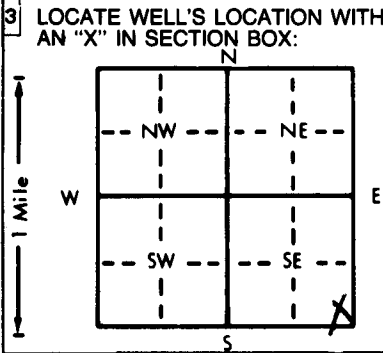

4 DEPTH OF COMPLETED WELL: 170 ft. ELEVATION:
Depth(s) Groundwater Encountered 1. 143 ft. 2. ft. 3. ft.
WELL'S STATIC WATER LEVEL: 143 ft. below land surface measured on mo/day/yr 4-15-91
Pump test data: Well water was ft. after hours pumping gpm
Est. Yield: 15 gpm Well water was ft. after hours pumping gpm
Bore Hole Diameter: 8 in. to 173 ft., and in. to ft.
WELL WATER TO BE USED AS:
1 Domestic 3 Feedlot 6 Oil field water supply 9 Dewatering 12 Other (Specify below)
2 Irrigation 4 Industrial 7 Lawn and garden only 10 Monitoring well
Was a chemical/bacteriological sample submitted to Department? Yes No X If yes, mo/day/yr sample was submitted
Water Well Disinfected? Yes No

5 TYPE OF BLANK CASING USED:
1 Steel 3 RMP (SR) 5 Wrought iron 8 Concrete tile CASING JOINTS: Glued Clamped
2 PVC 4 ABS 6 Asbestos-Cement 9 Other (specify below) Welded
7 Fiberglass Threaded
Blank casing diameter: 5 in. to 140 ft., Dia in. to ft., Dia in. to ft.
Casing height above land surface: 12 in., weight 200 lbs./ft. Wall thickness or gauge No. SDR 2.1
TYPE OF SCREEN OR PERFORATION MATERIAL:
1 Steel 3 Stainless steel 5 Fiberglass 7 PVC 8 RMP (SR) 10 Asbestos-cement 11 Other (specify)
2 Brass 4 Galvanized steel 6 Concrete tile 9 ABS 12 None used (open hole)
SCREEN OR PERFORATION OPENINGS ARE:
1 Continuous slot 3 Mill slot 5 Gauzed wrapped 8 Saw cut 11 None (open hole)
2 Louvered shutter 4 Key punched 6 Wire wrapped 9 Drilled holes
7 Torch cut 10 Other (specify)
SCREEN-PERFORATED INTERVALS: From 140 ft. to 170 ft., From ft. to ft.
GRAVEL PACK INTERVALS: From 100 ft. to 170 ft., From ft. to ft.
returns From 20 ft. to 100 ft., From ft. to ft.

6 GROUT MATERIAL: 1 Neat cement 2 Cement grout 3 Bentonite 4 Other
Grout intervals: From 0 ft. to 20 ft., From ft. to ft., From ft. to ft.
What is the nearest source of possible contamination:
1 Septic tank 4 Lateral lines 7 Pit privy 10 Livestock pens 14 Abandoned water well
2 Sewer lines 5 Cess pool 8 Sewage lagoon 11 Fuel storage 15 Oil well/Gas well
3 Watertight sewer lines 6 Seepage pit 9 Feedyard 12 Fertilizer storage 16 Other (specify below)
13 Insecticide storage
Direction from well? Southeast How many feet? 70'

FROM	TO	LITHOLOGIC LOG	FROM	TO	PLUGGING INTERVALS
0	40	Clay			
40	60	Sand and clay			
60	75	Rock and Sand			
75	90	Sand and gravel			
90	100	sand and clay			
100	125	sandstone			
125	170	sand and gravel			

7 CONTRACTOR'S OR LANDOWNER'S CERTIFICATION: This water well was (1) constructed, (2) reconstructed, or (3) plugged under my jurisdiction and was completed on (mo/day/year) 5-15-91 and this record is true to the best of my knowledge and belief. Kansas Water Well Contractor's License No. 484 This Water Well Record was completed on (mo/day/yr) 5-15-91 under the business name of Schaal Drilling, Co. by (signature) *Paul Schaal*