


1 LOCATION OF WATER WELL: C # 17 Fraction SE 1/4 NW 1/4 SE 1/4 Section Number 21 Township Number T 4 S Range Number R 42 E 0

Distance and direction from nearest town or city street address of well if located within city?
You tell me say 12 to 15 mi South west Saint Francis, Ks.

2 WATER WELL OWNER: Royce Wiley
 RR#, St. Address, Box # 9090a Star Route Board of Agriculture, Division of Water Resources
 City, State, ZIP Code St. Francis, Kansas 66256 Application Number:

3 LOCATE WELL'S LOCATION WITH AN "X" IN SECTION BOX:

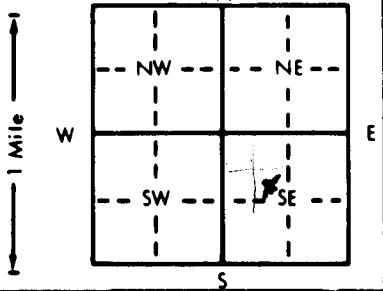

4 DEPTH OF COMPLETED WELL: 130 ft. ELEVATION:

Depth(s) Groundwater Encountered 1. 78 ft. 2. ft. 3. ft.
 WELL'S STATIC WATER LEVEL 78 ft. below land surface measured on mo/day/yr 5-9-89
 Pump test data: Well water was ft. after hours pumping gpm
 Est. Yield 15 gpm: Well water was ft. after hours pumping gpm
 Bore Hole Diameter 8 in. to 130 ft., and in. to ft.
 WELL WATER TO BE USED AS:
 5 Public water supply 8 Air conditioning 11 Injection well
 ① Domestic 3 Feedlot 6 Oil field water supply 9 Dewatering 12 Other (Specify below) live stock
 2 Irrigation 4 Industrial 7 Lawn and garden only 10 Observation well Range
 Was a chemical/bacteriological sample submitted to Department? Yes.....No.....
 Water Well Disinfected? Yes No

5 TYPE OF BLANK CASING USED:
 1 Steel 3 RMP (SR) 5 Wrought iron 8 Concrete tile CASING JOINTS: Glued Clamped

2 PVC 4 ABS 7 Fiberglass Threaded

Blank casing diameter 4 1/2 in. to 110 ft., Dia in. to ft., Dia in. to ft.
 Casing height above land surface 12 in., weight 160# lbs./ft. Wall thickness or gauge No. SDR-26

TYPE OF SCREEN OR PERFORATION MATERIAL:
 1 Steel 3 Stainless steel 5 Fiberglass 8 RMP (SR) 10 Asbestos-cement
 2 Brass 4 Galvanized steel 6 Concrete tile 9 ABS 11 Other (specify)

SCREEN OR PERFORATION OPENINGS ARE:
 1 Continuous slot 3 Mill slot 5 Gauzed wrapped 8 Saw cut 11 None (open hole)
 2 Louvered shutter 4 Key punched 6 Wire wrapped 9 Drilled holes
 7 Torch cut 10 Other (specify)

SCREEN-PERFORATED INTERVALS: From 110' ft. to 130' ft., From ft. to ft.
 From ft. to ft., From ft. to ft.
 GRAVEL PACK INTERVALS: From 70' ft. to 130' ft., From ft. to ft.
 From ft. to ft., From ft. to ft.

6 GROUT MATERIAL: 1 Neat cement 2 Cement grout 3 Bentonite 4 Other

Grout Intervals: From 0 ft. to 20 ft., From ft. to ft., From ft. to ft.

What is the nearest source of possible contamination: RANGE LIVESTOCK MANURE
 1 Septic tank 4 Lateral lines 7 Pit privy 10 Livestock pens 14 Abandoned water well
 2 Sewer lines 5 Cess pool 8 Sewage lagoon 11 Fuel storage 15 Oil well/Gas well
 3 Watertight sewer lines 6 Seepage pit 9 Feedyard 12 Fertilizer storage 16 Other (specify below)
 13 Insecticide storage

Direction from well? ANY How many feet? VARIOUS

FROM	TO	LITHOLOGIC LOG	FROM	TO	LITHOLOGIC LOG
0	20	Sand & Clay			
20	40	Sand & gravel			
40	60	Sand & Clay			
60	80	Sand & Clay			
80	100	Sand & gravel			
100	120	Sand & gravel			
120	125	Sand & gravel			
125	130	Sand & gravel			
130		Shale			

7 CONTRACTOR'S OR LANDOWNER'S CERTIFICATION: This water well was (1) constructed (2) reconstructed, or (3) plugged under my jurisdiction and was completed on (mo/day/year) 5-9-89 and this record is true to the best of my knowledge and belief. Kansas Water Well Contractor's License No. 484 This Water Well Record was completed on (mo/day/yr) 5-24-89 under the business name of Schaal Drilling Company by (signature) Ruben Schaal

INSTRUCTIONS: Use typewriter or ball point pen. PLEASE PRESS FIRMLY and PRINT clearly. Please fill in blanks, underline or circle the correct answers. Send top three copies to Kansas Department of Health and Environment, Bureau of Water Protection, Topeka, Kansas 66620-7320, Telephone: 913-862-9360. Send one to WATER WELL OWNER and retain one for your records.