USE TYPEWRITER OR BALL POINT PEN-PRESS FIRMLY, PRINT CLEARLY.

WATER WELL RECORD
KSA 82a-1201-1215

Kansas Department of Health and Environment-Division of Environment
(Water well Contractors)
Topeka, Kansas 66620

1. Location of well:	County	Fraction	Section number	Township number	Range number
	Cheyenne	SE 1/4 SW 1/4 SW 1/4	22	T 4 S	R 42 (W)

2. Distance and direction from nearest town or city: ST FRANCIS
Street address of well location if in city: 11 W 5 S 3/4 W

3. Owner of well: WILEY BROS
R.R. or street: BOX 25 JUQUASTAR ROUTE
City, state, zip code: ST FRANCIS KS 67756

4. Locate with "X" in section below:

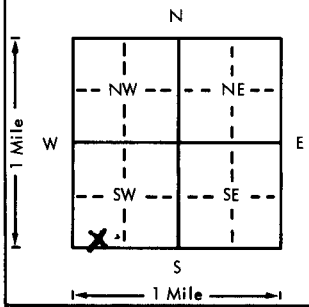

Sketch map: PASTURE

6. Bore hole dia. 8 in. Completion date 8-12-77
Well depth 129 ft.

7. __ Cable tool X Rotary __ Driven __ Dug
__ Hollow rod __ Jetted __ Bored __ Reverse rotary

8. Use: X Domestic __ Public supply __ Industry
__ Irrigation __ Air conditioning __ Stock
__ Lawn __ Oil field water __ Other

9. Casing: Material Plastic Height: Above ~~or below~~
Threaded ___ Welded ___ Surface 12 in.
RMP ___ PVC X Weight ___ lbs./ft.
Dia 4 in. to 109 ft. depth Wall Thickness: inches or
Dia. ___ in. to ___ ft. depth gage No. .237

5. Type and color of material	From	To
M GRAVEL, SANDY CLAY	80	85
M GRAVEL, SANDSTONE	85	107
FINE SAND, M GRAVEL	107	112
M GRAVEL	112	122
OCHRE	122	129
BROCK 122'		
(Use a second sheet if needed)		

10. Screen: Manufacturer's name JESS & LOWELL
Type LOWER Dia. 5
Slot/gauze .258 Length 20
Set between 109 ft. and 139 ft.
___ ft. and ___ ft.
Gravel pack? YES Size range of material 18

11. Static water level: mo./day/yr.
88 ft. below land surface Date 7-19-77

12. Pumping level below land surfaces:
101 ft. after 3 hrs. pumping 20 g.p.m.
___ ft. after ___ hrs. pumping ___ g.p.m.
Estimated maximum yield 40 g.p.m.

13. Water sample submitted: mo./day/yr.
___ Yes X No Date ___

14. Well head completion:
YES Pitless adapter 12 inches above grade

15. Well grouted? YES
With: ___ Neat cement ___ Bentonite X Concrete
Depth: From 5 ft. to 15 ft.

16. Nearest source of possible contamination:
ft. ___ Direction ___ Type PASTURE
Well disinfected upon completion? X Yes ___ No

17. Pump: Not installed
Manufacturer's name Red Jacket
Model number 14BC HP 1 Volts 230
Length of drop pipe 126 ft. capacity 10 g.p.m.
Type:
X Submersible ___ Turbine
___ Jet ___ Reciprocating
___ Centrifugal ___ Other

T 4 R 42 (W) Sec 22 SE 1/4 SW 1/4 SW 1/4

18. Elevation:
Topography:
___ Hill
___ Slope
X Upland
___ Valley

19. Remarks: 3540 (TOPO)

20. Water well contractor's certification:
This well was drilled under my jurisdiction and this report is true to the best of my knowledge and belief.
Business name S&H Drilling Co Inc License No. 16 6
Address Goodland Kansas
Signed Bill Clifford Date
Authorized representative 8-15-77

Forward the white, blue and pink copies to the Department of Health and Environment

Form WWC-5