


1 LOCATION OF WATER WELL:	Fraction	Section Number	Township Number	Range Number
County: <u>Cheyenne</u>	<u>NE 1/4 NE 1/4 SE 1/4</u>	<u>34</u>	<u>T 4 S</u>	<u>R 42 W E/W</u>

Distance and direction from nearest town or city street address of well if located within city?
N/A - LOCATION CONFIRMED BY GMD #4

2 WATER WELL OWNER: Leta O'Brien
 RR#, St. Address, Box # : Box 16
 City, State, ZIP Code : St. Francis, KS 67756
 Board of Agriculture, Division of Water Resources
 Application Number:

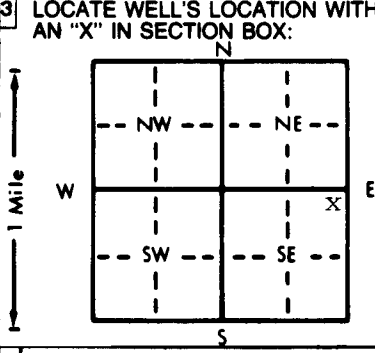


4 DEPTH OF COMPLETED WELL: 40 ft. ELEVATION: _____ ft.
 Depth(s) Groundwater Encountered 1. _____ ft. 2. _____ ft. 3. _____ ft.
 WELL'S STATIC WATER LEVEL: 3.0 ft. below land surface measured on mo/day/yr _____ ft.
 Pump test data: Well water was _____ ft. after _____ hours pumping _____ gpm
 Est. Yield _____ gpm: Well water was _____ ft. after _____ hours pumping _____ gpm
 Bore Hole Diameter: _____ in. to _____ ft., and _____ in. to _____ ft.
 WELL WATER TO BE USED AS:
 1 Domestic 2 Irrigation 3 Feedlot 4 Industrial
 5 Public water supply 6 Oil field water supply 7 Lawn and garden only
 8 Air conditioning 9 Dewatering 10 Monitoring well
 11 Injection well 12 Other (Specify below) _____
 Was a chemical/bacteriological sample submitted to Department? Yes.....No.....; If yes, mo/day/yr sample was submitted _____
 Water Well Disinfected? Yes _____ No _____

5 TYPE OF BLANK CASING USED:
 1 Steel 2 PVC 3 RMP (SR) 4 ABS
 5 Wrought iron 6 Asbestos-Cement 7 Fiberglass
 8 Concrete tile 9 Other (specify below) _____
 Blank casing diameter: 6 in. to _____ ft., Dia _____ in. to _____ ft., Dia _____ in. to _____ ft.
 Casing height above land surface: 0 in., weight _____ lbs./ft. Wall thickness or gauge No. _____
 TYPE OF SCREEN OR PERFORATION MATERIAL:
 1 Steel 2 Brass 3 Stainless steel 4 Galvanized steel
 5 Fiberglass 6 Concrete tile 7 PVC 8 RMP (SR) 9 ABS
 10 Asbestos-cement 11 Other (specify) _____
 12 None used (open hole) _____
 SCREEN OR PERFORATION OPENINGS ARE:
 1 Continuous slot 2 Louvered shutter 3 Mill slot 4 Key punched
 5 Gauzed wrapped 6 Wire wrapped 7 Torch cut 8 Saw cut 9 Drilled holes
 10 Other (specify) _____
 11 None (open hole) _____
 SCREEN-PERFORATED INTERVALS: From _____ ft. to _____ ft., From _____ ft. to _____ ft.
 From _____ ft. to _____ ft., From _____ ft. to _____ ft.
 GRAVEL PACK INTERVALS: From _____ ft. to _____ ft., From _____ ft. to _____ ft.
 From _____ ft. to _____ ft., From _____ ft. to _____ ft.

6 GROUT MATERIAL: 1 Neat cement 2 Cement grout 3 Bentonite 4 Other HOLE PLUG
 Grout Intervals: From 6 ft. to 15 ft., From _____ ft. to _____ ft., From _____ ft. to _____ ft.
 What is the nearest source of possible contamination:
 1 Septic tank 2 Sewer lines 3 Watertight sewer lines
 4 Lateral lines 5 Cess pool 6 Seepage pit
 7 Pit privy 8 Sewage lagoon 9 Feedyard
 10 Livestock pens 11 Fuel storage 12 Fertilizer storage 13 Insecticide storage
 14 Abandoned water well 15 Oil well/Gas well 16 Other (specify below) _____
 Direction from well? _____ How many feet? _____

FROM	TO	LITHOLOGIC LOG	FROM	TO	PLUGGING INTERVALS
	ENTER				
			40	20	REMOVED UPPER 4 FT CASING SAND
			20	15	CLAY
	PLUGGING		15	6	HOLE PLUG
			6	0	SURFACE DIRT + HOLE PLUG
	INFORMATION				
	AT				
	RIGHT				

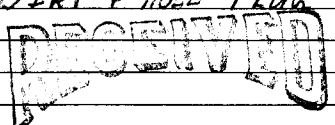

FEB 07 1990

DIVISION OF ENVIRONMENT

7 CONTRACTOR'S OR LANDOWNER'S CERTIFICATION: This water well was (1) constructed, (2) reconstructed, or (3) plugged under my jurisdiction and was completed on (mo/day/year) _____ and this record is true to the best of my knowledge and belief. Kansas Water Well Contractor's License No. _____ This Water Well Record was completed on (mo/day/yr) 11-4-90 under the business name of Leta O'Brien by (signature) Leta O'Brien

OFFICE USE ONLY