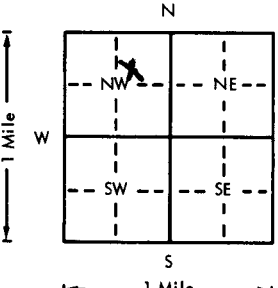
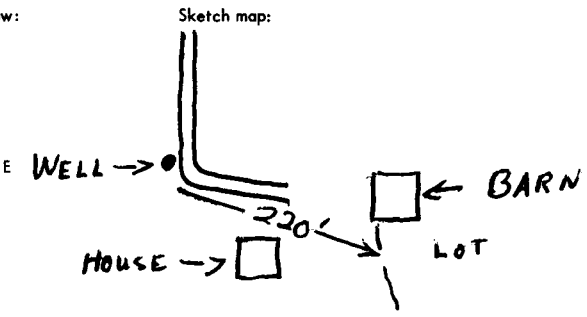


USE TYPEWRITER OR BALL POINT PEN-PRESS FIRMLY, PRINT CLEARLY.

WATER WELL RECORD  
KSA 82a-1201-1215

Kansas Department of Health and Environment-Division of Environment  
(Water well Contractors)  
Topeka, Kansas 66620

1. Location of well:		County <b>Republic</b>	Fraction <b>SW 1/4 NE 1/4 NW 1/4</b>	Section number <b>28</b>	Township number <b>T 4</b>	Range number <b>S R 5W E/W</b>
2. Distance and direction from nearest town or city: <b>8S-2E-SSR from Courtland, Ks.</b> Street address of well location if in city:				3. Owner of well: <b>Phillip Johnson</b> R.R. or street: <b>Rt. 1</b> City, state, zip code: <b>Jamestown, Ks. 66948</b>		
4. Locate with "X" in section below: 				Sketch map: 		
5. Type and color of material				From	To	6. Bore hole dia. <b>8 1/2</b> in. Completion date <b>11/2/78</b> Well depth <b>122 1/2</b> ft.
Topsoil				0	1	7. <input type="checkbox"/> Cable tool <input checked="" type="checkbox"/> Rotary <input type="checkbox"/> Driven <input type="checkbox"/> Dug <input type="checkbox"/> Hollow rod <input type="checkbox"/> Jetted <input type="checkbox"/> Bored <input type="checkbox"/> Reverse rotary
Clay, brown				1	10	8. Use: <input checked="" type="checkbox"/> Domestic <input type="checkbox"/> Public supply <input type="checkbox"/> Industry <input type="checkbox"/> Irrigation <input type="checkbox"/> Air conditioning <input type="checkbox"/> Stock <input type="checkbox"/> Lawn <input type="checkbox"/> Oil field water <input type="checkbox"/> Other
Clay, yellow				10	16	9. Casing: Material <b>PVC</b> Height: Above or below Threaded <input type="checkbox"/> Welded <input checked="" type="checkbox"/> Surface <b>30</b> in. RMP <input type="checkbox"/> PVC Weight <b>2.84</b> lbs./ft. Dia. <b>5</b> in. to <b>122</b> ft. depth Wall Thickness: inches or Dia. <input type="checkbox"/> in. to <input type="checkbox"/> ft. depth gage No. <b>265</b>
Clay, yellow & some limestone boulders				16	29	10. Screens: Manufacturer's name <b>Jetstream</b> Type <b>PVC slotted</b> Dia. <b>5"</b> Slot/gauze <b>.025</b> Length <b>60'</b> Set between <b>62</b> ft. and <b>122</b> ft. ft. and <input type="checkbox"/> ft. Gravel pack? <input checked="" type="checkbox"/> Yes <input type="checkbox"/> No Size range of material <b>47-B</b>
Clay, yellow & limestone sand, fine to medium				29	38	11. Static water level: <b>75</b> ft. below land surface Date <b>11/2/78</b> <small>no./day/yr.</small>
Clayshale, blue				38	63	12. Pumping level below land surfaces: <input type="checkbox"/> ft. after <input type="checkbox"/> hrs. pumping <input type="checkbox"/> g.p.m. <input type="checkbox"/> ft. after <input type="checkbox"/> hrs. pumping <input type="checkbox"/> g.p.m. Estimated maximum yield <b>2</b> g.p.m.
<del>Sand</del> Shale, blue with some sandstone, fine, gray				63	67	13. Water sample submitted: <input type="checkbox"/> Yes <input checked="" type="checkbox"/> No Date <input type="checkbox"/>
Sandstone, fine gray				67	80	14. Well head completion: <input type="checkbox"/> Pitless adapter <input type="checkbox"/> _____ Inches above grade
Shale, blue with some sandstone layers				80	99	15. Well grouted? <input checked="" type="checkbox"/> <b>yes</b> With: <input checked="" type="checkbox"/> Neat cement <input type="checkbox"/> Bentonite <input type="checkbox"/> Concrete Depth: From <b>0</b> ft. to <b>20</b> ft.
Sandstone, fine gray with shale layers blue				99	119	16. <del>Nearest</del> source of possible contamination: ft. <b>220</b> Direction <b>SE</b> Type <b>barnyard</b> Well disinfected upon completion? <input checked="" type="checkbox"/> Yes <input type="checkbox"/> No
<del>Sand</del> Shale, blue				119	123	17. Pump: <input checked="" type="checkbox"/> Not installed Manufacturer's name _____ Model number _____ HP _____ Volts _____ Length of drop pipe _____ ft. capacity _____ g.p.m. Type: <input type="checkbox"/> Submersible <input type="checkbox"/> Turbine <input type="checkbox"/> Jet <input type="checkbox"/> Reciprocating <input type="checkbox"/> Centrifugal <input type="checkbox"/> Other
(Use a second sheet if needed)						
18. Elevation: <b>1430 ft</b>		19. Remarks:		20. Water well contractor's certification: This well was drilled under my jurisdiction and this report is true to the best of my knowledge and belief. <b>Holly Well Drilling 370</b> Business name License No. Address <b>Rt.1, Crete, Ne.</b> Signed <b>Gary T. Holly</b> Date <b>11/2/78</b> Authorized representative		
Topography: <input type="checkbox"/> Hill <input checked="" type="checkbox"/> Slope <input type="checkbox"/> Upland <input type="checkbox"/> Valley						

4  
5  
